IREDELL COUNTY HEALTH DEPARTMENT

Statesville Phone TR 3-7271 Mooresville Phone NO 3-1271

PERMIT TO INSTALL SEPTIC TANK

Permit NO. Smith & Munday Bldrs. Permit Date Feb-22 1964

Owner Richard K. Mattox Address 329 Bo St. St. C, Ky

Installed By C Hoke Address (R)


Location of Property on left past Colony Acres on Chipley Ford Rd past Amoco Sta. white

Tank		Capacity		Length of Lines		Fixtures	
Block	( )	800	( )	150'	( )	No. of Baths	(3)
Precast	(✓)	900	( )	175'	( )	Dishwasher	(✓)
		1000	( )	200'	( )	Garbage Grdr.	( )
		1100	( )	225'	( )	Auto-Washer	(✓)
		1200	( )	250'	( )	Other	
		Other 1500		Other 350			

NOTIFY HEALTH DEPARTMENT AT LEAST EIGHT HOURS BEFORE TANK IS TO BE INSPECTED.

Final Inspection 2-22 1964 Approved (✓) Disapproved ( )

Remarks well 300'

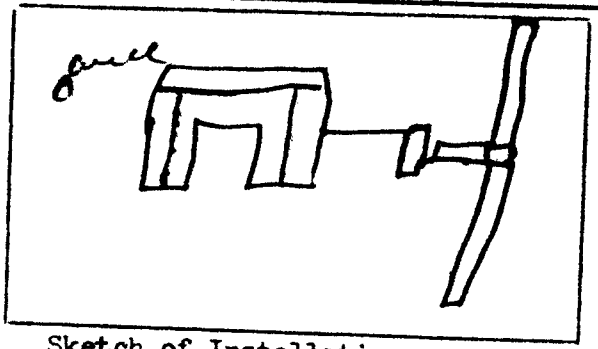

Sketch of Installation

Sanitarian