IREDELL COUNTY HEALTH DEPARTMENT

Statesville Phone TR 3-7271 Mooresville Phone NO 3-1271

PERMIT TO INSTALL SEPTIC TANK

Permit NO. 45 Permit Date DEC. 1 1971

Owner Hope Bros. Builders Address Statesville, N.C.

Installed By Adams Septic Tank Ser. Address Taylorsville, N.C.

Location of Property Chipley Park - Road #1332 - Turn Left 3rd Street House on Rt.


Lot. 40

Tank		Capacity		Length of Lines		Fixtures	
Block	( )	1000	(✓)	225'	( )	No. of Baths	(1½)
Precast	(✓)	1250	( )	250'	( )	Dishwasher	( )
		1500	( )	Other 300 900 Sq. Ft.		Garbage Grdr.	( )
		Other				Other	

NOTIFY HEALTH DEPARTMENT AT LEAST EIGHT HOURS BEFORE TANK IS TO BE INSPECTED.

Final Inspection DEC. 1 1971 Approved (✓) Disapproved ( )

Remarks Community Water Supply

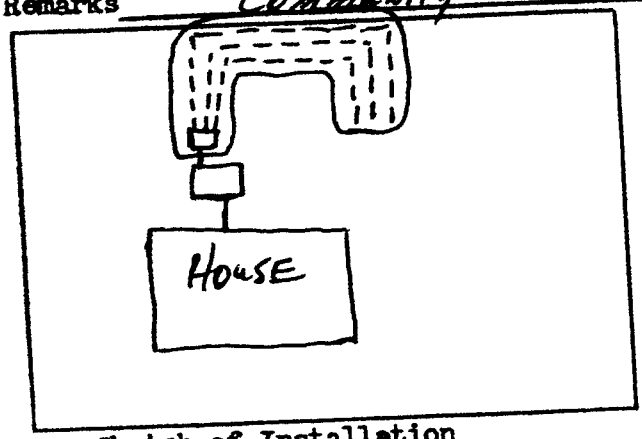

Sketch of Installation

Glenn Locke

Sanitarian