IREDELL COUNTY HEALTH DEPARTMENT

Statesville Phone TR 3-7271 Mcoresville Phone NO 3-1271

PERMIT TO INSTALL SEPTIC TANK

Permit No. 3 8 6 Permit Date 8-13-1965

Owner Hope Bros Bldrs. Address R7

Installed By Choate & Sons. Address R7


Location of Property Chipley Park #7

Tank		Capacity		Length of Lines		Fixtures	
Block	( )	1000	(4)	225'	(4)	No. of Baths	(2)
Precast	(4)	1250	( )	250'	( )	Dishwasher	( )
Lock		1500	( )	Other		Garbage Grdr.	( )
		Other				Other	

NOTIFY HEALTH DEPARTMENT AT LEAST EIGHT HOURS BEFORE TANK IS TO BE INSPECTED.

Final Inspection 19 Approved ( ) Disapproved ( )

Remarks Central water supply. No liable any harm from grade or landscape

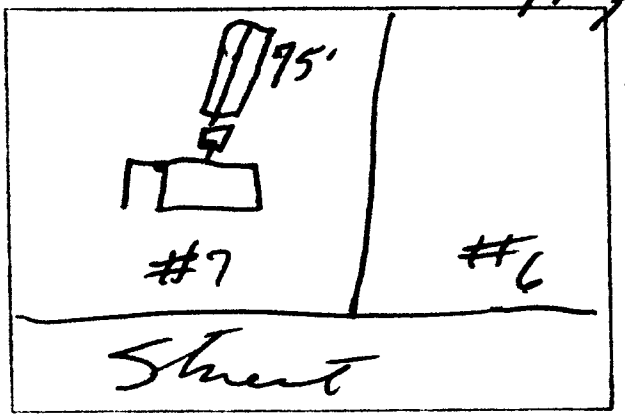

Sketch of Installation

Sanitarian