IREDELL COUNTY HEALTH DEPARTMENT

Statesville Phone TR 3-7271 Mooresville Phone NO 3-1271

PERMIT TO INSTALL SEPTIC TANK

Permit No. _____ Permit Date June 18 1964

Owner Hope Bros. Bldrs. Inc. Address R7 city

Installed By C Hoke & Sons. Address R7


Location of Property Chifley Park # 5 - basement on left front well.

Tank		Capacity		Length of Lines		Fixtures	
Block	( )	1000	(✓)	225'	(✓)	No. of Baths	(2)
Precast	(✓)	1250	( )	250'	( )	Dishwasher	( )
Hookstone		1500	( )	Other _____		Garbage Grdr.	( )
		Other _____				Other _____	

NOTIFY HEALTH DEPARTMENT AT LEAST EIGHT HOURS BEFORE TANK IS TO BE INSPECTED.

Final Inspection _____ 19___ Approved ( ) Disapproved ( )

Remarks Central water supply - Confined area - tight soil wooded, rock subbase. may not drain too well. Not liable any grade changes or landscape harm.

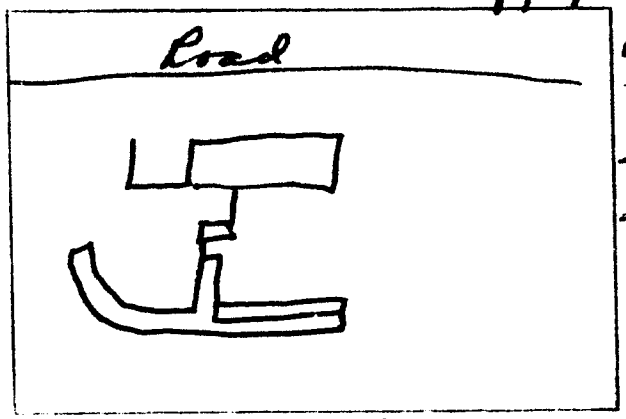

Sketch of Installation

T. D. H.

Sanitarian