IREDELL COUNTY HEALTH DEPARTMENT

Statesville Phone TR 3-7271 Mooresville Phone NO 3-1271

PERMIT TO INSTALL SEPTIC TANK

Permit No. 175 Permit Date 1 June 1970

Owner Blake Pratt Address

Installed By Adams Septic Tank Serv. Address Taylorsville N.C.

Location of Property Chipley Park Road # 1945


6th House on Right,

Tank		Capacity		Length of Lines		Fixtures	
Block	( )	1000	(✓)	225'	(✓)	No. of Baths	(✓)
Precast	(✓)	1250	( )	250'	( )	Dishwasher	( )
		1500	( )	Other		Garbage Grdr.	( )
		Other				Other	

NOTIFY HEALTH DEPARTMENT AT LEAST EIGHT HOURS BEFORE TANK IS TO BE INSPECTED.

Final Inspection 1 June 1970 Approved (✓) Disapproved ( )

Remarks Central Well —

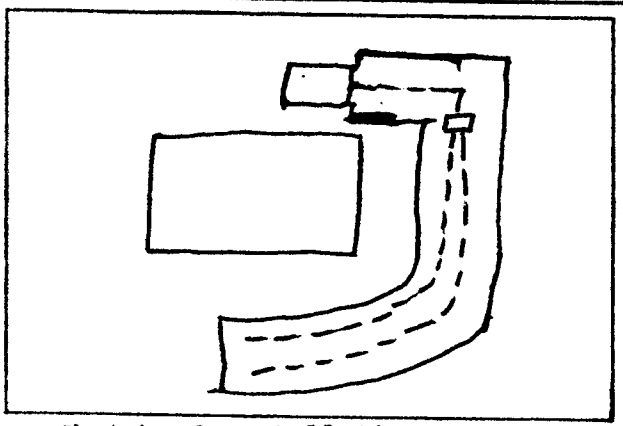

Sketch of Installation

Adams Sept. Tk. Serv.

Sanitarian