IREDELL COUNTY HEALTH DEPARTMENT

STATESVILLE 704-878-5305 MOORESVILLE 704-664-5281

IMPROVEMENT PERMIT / AUTHORIZATION TO CONSTRUCT / OPERATION PERMIT / EXISTING SYSTEM INSPECTION

PERMIT# 070935 PIN# 4736 48-2084 DATE 1-6-98

OWNER OR CONTRACTOR CLAUDETTE BALLARD PHONE: Business 929-0436 Home 878-6772

ADDRESS 2032 HAZELWOOD DRIVE, STATESVILLE, NC 28625

LOCATION NC 115 N, TR S. CHIPLEY FORD, TL CROSSWHITE TO END, TR HARRIET LANE, 2ND LOT ON LEFT

SUBDIVISION THOMAS WEST BLOCK / SECTION LOT 42 LOT AREA 100' X 200' SITE CLASS. PS DESIGN FLOW 360 L.T.A.R. 0.33 GPD/FT²

Septic Tank: 1000 Gallons; STB 10/2 Date 11-2-98
Pump Tank: 1000 Gallons; PT 17 Date 11-29-98
Pump Make: HydroMatic Model SHEF 50A1 Serial No.
Nitrification Field: No Fields 1 Square Feet EQ. TO 1080 Linear Feet 270+
No Lines FIVE Trench Width 36" Max Trench Bottom Depth 36" Gravel Depth 12"

☑ New System ☐ Repair System Type: I, II, (III), IV, V, VI
System Description: CHAMBERED PUMP FED
Repair System Description: CONVENTIONAL SYSTEM
Maintenance Agreement Required: ☐ Yes ☑ No

☑ House/Mod. Home No. Bedrooms 3
☐ Mobile Home No. Bathrooms 2
☐ Business No. Employees
☐ Other


☐ Slab ☑ Crawl Space ☐ Basement w/plumbing ☐ Basement wo/plumbing

Water Supply: ☐ Individual ☑ Public ☐ Community


Comments/Conditions: (1) INSTALL 45 CHAMBERS IN FIVE EQUAL LENGTH LINES ON CONTOUR AS SHOWN (2) KEEP SYSTEM MINIMUM 5 FEET FROM PROPERTY LINE (3) SEE ATTACHED SHEETS FOR PUMP & PRESSURE MANIFOLD REQUIREMENTS.

Comments/Conditions:

INITIAL SITE SKETCH SCALE: 1" = 40'

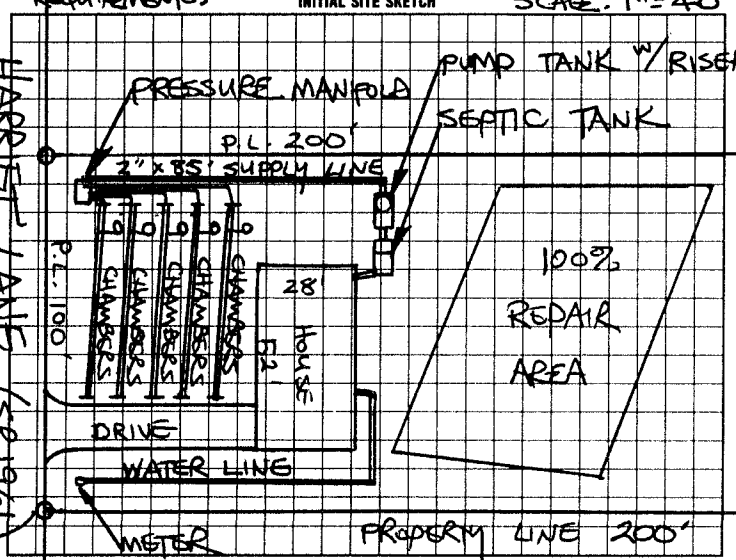

AS BUILT SKETCH

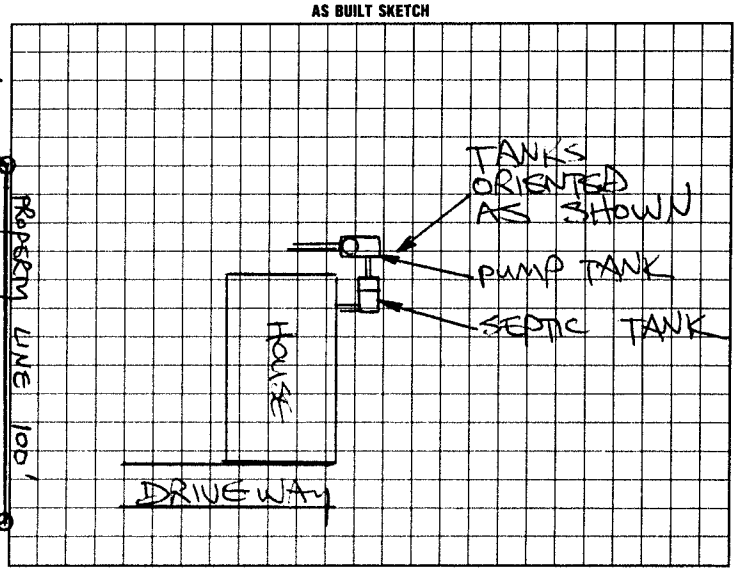

I understand that this permit can be suspended or revoked if any false information is supplied toward securing the permit/any unauthorized changes are made to the site/any unauthorized changes are made in the installation of the system. Improvement Permit with plat valid without expiration. Improvement Permit with site plan valid for sixty months. Authorization to Construct is valid for a period equal to that of Improvement Permit – not to exceed sixty months.

Signed: Claudette Ballard date

Improvement Permit by: STEVE HEDRICK date 1-6-98

Authorization to Construct by: STEVE HEDRICK date 1-6-98

Installed by: KENNY MADISON

Operation Permit by: STEVE HEDRICK date 3-12-99

Existing System Inspection by: date

HEALTH DEPT. COPY: WHITE INSPECTION COPY (FINAL) GREEN OWNER COPY (FINAL) YELLOW INSPECTION COPY (INITIAL) PINK OWNER COPY (INITIAL) GOLD