IREDELL COUNTY HEALTH DEPARTMENT

STATESVILLE 704-878-5305 MOORESVILLE 704-664-5281

IMPROVEMENT PERMIT / CERTIFICATE OF COMPLETION / OPERATION PERMIT / EXISTING SYSTEM INSPECTION

PROPERTY DESCRIPTION NO. REPAIR CHOR VANG DATE 5-15-96 TAX MAP NO. Watershed: ☐ Yes ☑ No

OWNER OR CONTRACTOR PHONE: Business Home 876-0006

ADDRESS 198 HARRIET LANE

LOCATION NC115N, TR S. CHARLEY FORD RD, TL CROSSWHITE, TR HARRIET LANE, 2ND HOUSE ON LEFT

SUBDIVISION BLOCK / SECTION LOT LOT AREA SITE CLASS. PS DESIGN FLOW 360 L.T.A.R. EXISTING

Septic Tank: EXISTING Gallons; STB Date

Pump Tank: Gallons; PT Date

Pump Make: Model Serial No.

Nitrification Field: No Fields 1 Square Feet 300 Linear Feet 100

No Lines 1 Trench Width 36" Max Trench Bottom Depth 36" Gravel Depth 12"

☐ New System ☑ Repair System Type: I (II) III. IV. V. VI

System Description:

Repair System Description: CONVENTIONAL GRAVITY

Maintenance Agreement Required: ☐ Yes ☐ No

☑ House/Mod. Home No. Bedrooms 3

☐ Mobile Home No. Bathrooms 2

☐ Business No. Employees

☐ Other


☐ Slab ☑ Crawl Space ☐ Basement w/plumbing ☐ Basement wo/plumbing

Water Supply: ☐ Individual ☐ Community ☑ Public

Comments: ① PUMP-OUT SEPTIC TANK, REPLACE SANITARY TEE ② INSTALL NEW 1 3'x100' AS SHOWN INTERCEPTING EXISTING LINE AT LOCATION SHOWN, USING 24" STONE

Comments:

INITIAL SITE SKETCH

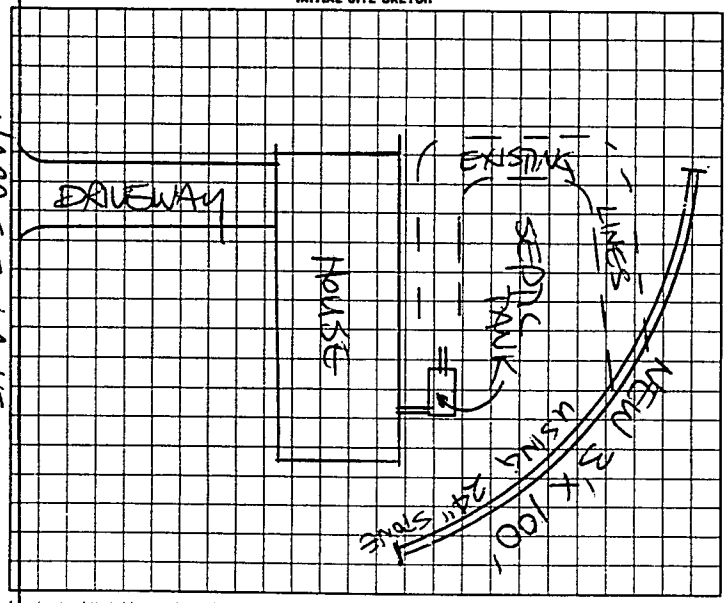

AS BUILT SKETCH

SYSTEM REPAIRED ACCORDING TO INITIAL SITE SKETCH

I understand that this permit can be suspended or revoked if any false information is supplied toward securing the permit/any unauthorized changes are made to the site/any unauthorized changes are made in the installation of the system.

AUTHORIZATION TO CONSTRUCT IS VALID FIVE (5) YEARS FROM DATE OF ISSUANCE. IMPROVEMENT PERMIT HAS NO EXPIRATION DATE.

Signed: Dina Vang

Improvement Permit by: STEVE HEDRICK date 5-15-96

~~Authorization to Construct~~ Existing System Inspection by: STEVE HEDRICK date 5-15-96

Installed by: JAMES HYDLER

~~Certificate of Completion by:~~ date

Operation Permit by: STEVE HEDRICK date 9-10-96

HEALTH DEPT COPY. WHITE | INSPECTION COPY (FINAL) GREEN | OWNER COPY (FINAL) YELLOW | INSPECTION COPY (INITIAL) PINK | OWNER COPY (INITIAL) GOLD

5 5 9 2 0 0