IREDELL COUNTY HEALTH DEPARTMENT

Statesville Office (704) 878-5305 Mooresville Office (704) 660-3625 PERMIT # 217318

IMPROVEMENT PERMIT / AUTHORIZATION TO CONSTRUCT / OPERATION PERMIT / EXISTING SYSTEM

PIN # 4736484512

APPLICANT: Gladys Carter APPLICANT ADDRESS: 103 Lark Ln Statesville NC

SITE ADDRESS: 103 Lark Ln - Statesville NC PHONE: 704-495-5976 ALT. PHONE: 704-876-1975

SITE DIRECTIONS: 115 N T/R Chipley Ford Rd T/L Harriet Ln T/R Lark Ln first on left

SUBDIVISION: Chipley Park Tsumas West Addition SECTION: 5B LOT # 47 LOT AREA: 0.5ac DESIGN FLOW: Ex L.T.A.R.: Ex

Septic Tank	1000 (gal)	STB	760	Date	9-14-16	☐ New System	☒ Repair	☐ Expansion	System Type: I II III IV V VI
Pump Tank	(gal)	PT		Date		System Description:			tank
Pump Make		Model	Poly106	Serial #	PL-68	Repair System Description:			
# Nitrification Fields	Ex	# Lines	Ex	Linear Ft:	Ex	Maintenance Agreement Required:	☐ YES	☒ NO	
Trench Width	Ex	Max. Trench Bottom Depth	Ex	Gravel Depth	Ex	☒ GRAVITY	☐ PRESSURE		

☒ Residence ☐ Business ☐ Other ☐ Slab ☐ Basement w/plumbing


No. Bedrooms Ex No. Persons Ex No. Employees ☒ Crawl Space

Water Supply: ☐ Private ☒ Public ☐ Community

☐ Basement w/o plumbing

Comments / Conditions: Pump, crush & fill existing tank
maintain 5' off any building foundation

INITIAL SITE SKETCH

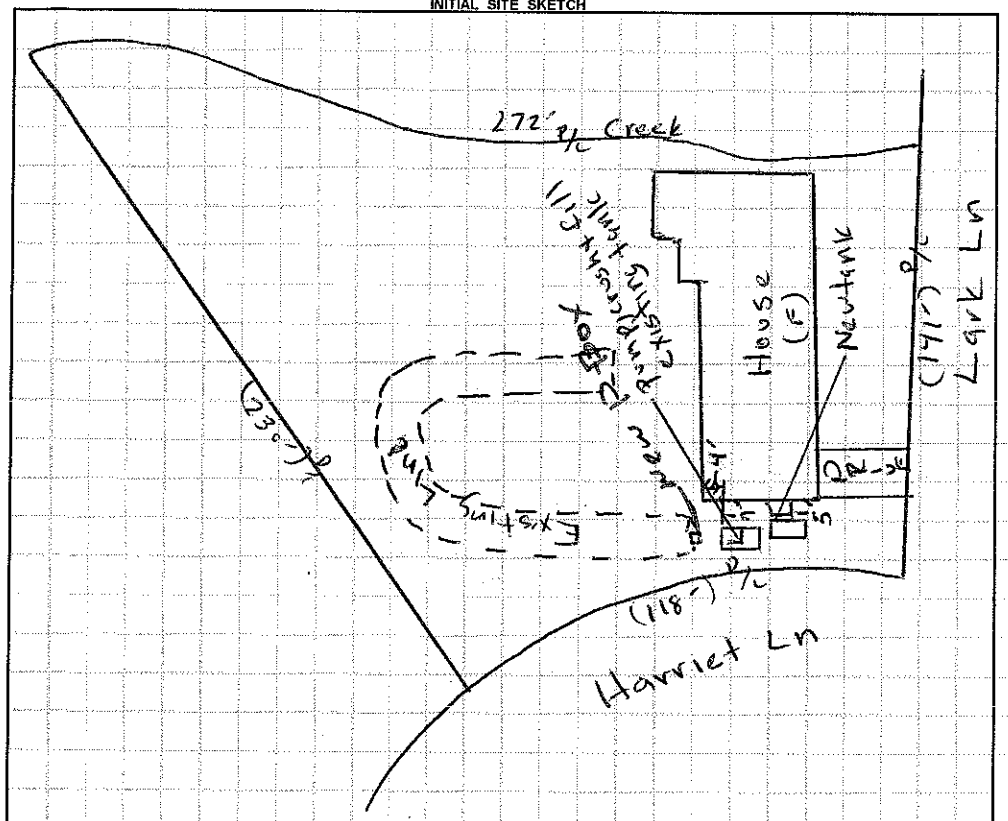

AS BUILT SKETCH

1"=50'

Installed as drawn

Permit can be suspended or revoked if any false information is supplied toward securing the permit / any unauthorized changes are made to the site / any unauthorized changes are made in the installation of the system. **CONTACT A LOCATOR SERVICE PRIOR TO ANY EXCAVATION**

☐ **IMPROVEMENT PERMIT** *with plat valid without expiration.* ☒ **IMPROVEMENT PERMIT** *with site plan valid for 60 mos.* ☒ **AUTHORIZATION TO CONSTRUCT** *valid for period equal to IMPROVEMENT PERMIT--not to exceed 60 mo.*

Owner / Applicant Signature: Gladys M Carter Date: 1-11-17 Installed by: Lentz Wastewater

IMPROVEMENT PERMIT by: Robert H. Snow Date: 12/30/16 OPERATION PERMIT by: Robert H. Snow Date: 01/18/17

AUTHORIZATION TO CONSTRUCT by: Robert H. Snow Date: 12/30/16 Existing System Inspected by: Date:

Health Dept. Copy - WHITE Applicant (Final Approval) - YELLOW Applicant (Conditional Approval) - PINK