IREDELL COUNTY HEALTH DEPARTMENT

Statesville Phone TR 3-7271 Mooresville Phone NO 3-1271

PERMIT TO INSTALL SEPTIC TANK

Permit No. 180 Permit Date 4-5 1972

Owner Hope Bros Builders Inc Address Statesville, NC

Installed By Hope Bros. Address Statesville, NC.

Location of Property Chipley Park.


Lot # 81

Tank		Capacity		Length of Lines		Fixtures	
Block	( )	1000	(✓)	225'	( )	No. of Baths	(1½)
Precast	(✓)	1250	( )	250'	( )	Dishwasher	( )
		1500	( )	Other 360 Sq Ft.		Garbage Grdr.	( )
		Other				Other	

NOTIFY HEALTH DEPARTMENT AT LEAST EIGHT HOURS BEFORE TANK IS TO BE INSPECTED.

Final Inspection 4-5 1972 Approved (✓) Disapproved ( )

Remarks Community WATER Supply

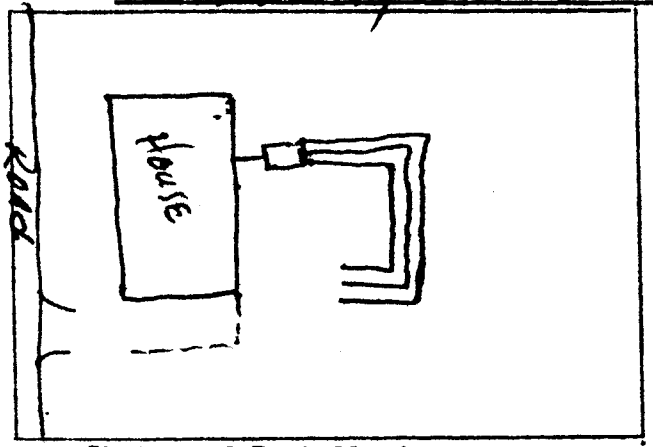

Sketch of Installation

Nitrification LINES About 6' DEEP —

Glenn Todd Jr

Sanitarian