IREDELL COUNTY HEALTH DEPARTMENT

Statesville Phone TR 3-7271 Mooresville Phone NO 3-1271

PERMIT TO INSTALL SEPTIC TANK

Permit No. 161 Permit Date _____ 19__

Owner Hope Bro Address Statesville NC

Installed By Hope Bro Address Statesville NC


Location of Property Out Chipley Ford Rd to Chipley Park T.R. on Rd #1945 go to end of Street T.R. Last house on R. Lot # 86

Tank		Capacity		Length of Lines		Fixtures	
Block	( )	1000	(✓)	225'	( )	No. of Baths	(1)
Precast	(✓)	1250	( )	250'	( )	Dishwasher	( )
		1500	( )	Other 900 sq ft		Garbage Grdr.	( )
		Other _____				Other _____	

NOTIFY HEALTH DEPARTMENT AT LEAST EIGHT HOURS BEFORE TANK IS TO BE INSPECTED.

Final Inspection 3-24 1972 Approved (✓) Disapproved ( )

Remarks Community Water Supply

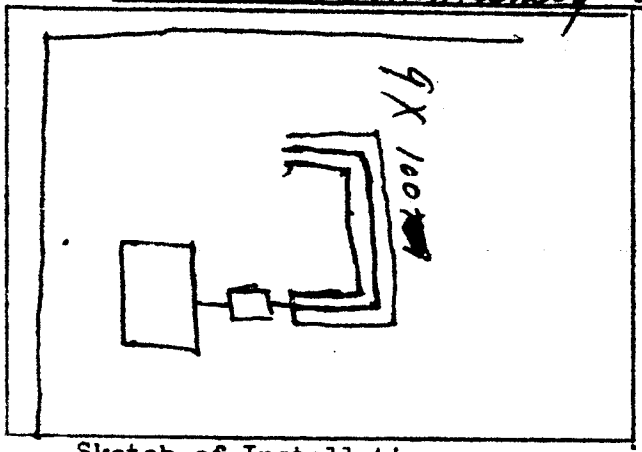

Sketch of Installation

E. A. Stevenson

Sanitarian