IREDELL COUNTY HEALTH DEPARTMENT

Statesville Phone TR 3-7271 Mooresville Phone NO 3-1271

Permit No. 185 — PERMIT TO INSTALL SEPTIC TANK

Permit Date 7-14 1972

Owner Hope Bros Builders Inc Address Statesville, NC

Installed By Hope Bros. Address Statesville, NC


Location of Property Chipley Park - Lot # 78

Tank		Capacity		Length of Lines		Fixtures	
Block	( )	1000	(✓)	225'	(✓)	No. of Baths	(2)
Precast	(✓)	1250	( )	250'	( )	Dishwasher	( )
		1500	( )	Other		Garbage Grdr.	( )
		Other				Other	

NOTIFY HEALTH DEPARTMENT AT LEAST EIGHT HOURS BEFORE TANK IS TO BE INSPECTED.

Final Inspection 7-14 1972 Approved (✓) Disapproved ( )

Remarks Community Water Supply

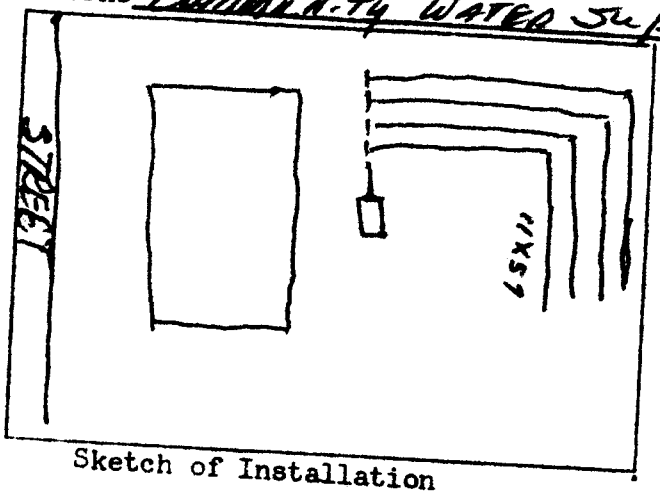

Sketch of Installation

Sanitarian