IREDELL COUNTY HEALTH DEPARTMENT

STATESVILLE 704-878-5305 MOORESVILLE 704-664-5281

IMPROVEMENT PERMIT / AUTHORIZATION TO CONSTRUCT / OPERATION PERMIT / EXISTING SYSTEM INSPECTION

PERMIT# 84088 PIN# 4736500725 DATE 12-13-99

OWNER OR CONTRACTOR Richard Oliver PHONE: Business Home 528 5113

ADDRESS PO Box 1363 Troutman N.C.

LOCATION 115 W TR Chipley Ford Rd across from westview Ln

SUBDIVISION Ft Dobbs Fm BLOCK / SECTION LOT 6 LOT AREA 2 acres SITE CLASS P5 DESIGN FLOW ~~480~~ 600 L.T.A.R. ~~.33~~ 0.30 gpd/ft

Septic Tank: 1000 Gallons; STB 312 Date 7-23-01

Pump Tank: Gallons; PT Date

Pump Make: Model Serial No. ~~530~~ ~~48066~~

Nitrification Field: No Fields 1 Square Feet 1440 Linear Feet ~~480~~ 600

No Lines ~~4~~ 5 Trench Width 36" Max Trench Bottom Depth 36" Gravel Depth 12"

☑ New System ☐ Repair System Type: I, II, III, IV, V, VI

System Description: Conv. Gravity

Repair System Description: " "

Maintenance Agreement Required: ☐ Yes ☑ No

☐ Slab ☑ Crawl Space ☐ Basement w/plumbing ☐ Basement wo/plumbing

☑ House/Mod. Home No. Bedrooms ~~4~~ 5

☐ Mobile Home No. Bathrooms ~~3~~ 3½


☐ Business No. Employees

☐ Other

Water Supply: ☐ Individual ☑ Public ☐ Community

Comments/Conditions:

INITAL SITE SKETCH

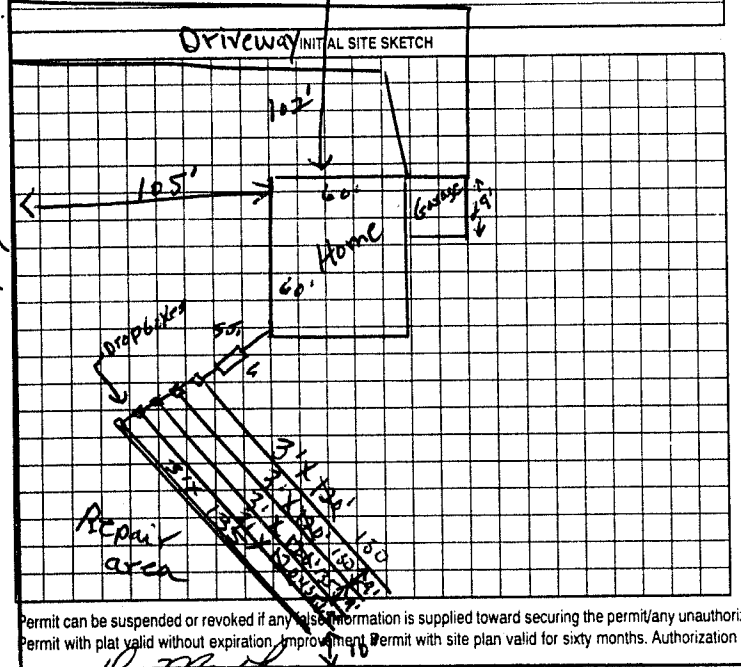

Comments/Conditions: 8-29 Check tank lines for 4 Bds. Note keep water line 10ft from system Plumb Gutter drains away from system

AS BUILT SKETCH

SYSTEM DRAINFIELD EXPANDED TO ACCOMODATE FIVE BEDROOMS (8-31-00) AT 0.30 LTAR AS SHOWN ON INITIAL SITE SKETCH.

Permit can be suspended or revoked if any false information is supplied toward securing the permit/any unauthorized changes are made to the site/any unauthorized changes are made in the installation of the system. Improvement Permit with plat valid without expiration. Improvement Permit with site plan valid for sixty months. Authorization to Construct is valid for a period equal to that of Improvement Permit – not to exceed sixty months.

Signed: [signature] date

Improvement Permit by: P.C. Moore date 10-13-99

Authorization to Construct by: P.C. Moore date 10-13-99

Installed by: Wes Lytton

Operation Permit by: STEVE HEDRICK date 8-31-00

Existing System Inspection by: date

HEALTH DEPT. COPY: WHITE OWNER COPY (FINAL): YELLOW OWNEH COPY (INITIAL): PINK

Chipley Ford Rd