THIS PERMIT REPLACES EXPIRED PERMIT DATED 4-13-95

IREDELL COUNTY HEALTH DEPARTMENT

STATESVILLE 704-878-5305 MOORESVILLE 704-664-5281

IMPROVEMENT PERMIT / AUTHORIZATION TO CONSTRUCT / OPERATION PERMIT / EXISTING SYSTEM INSPECTION

PERMIT# 088419 PIN# 4736-50-2889 DATE 5-13-2000

OWNER OR CONTRACTOR LOU EARNHARDT PHONE: Business 871-0845 Home

ADDRESS P.O. BOX 284 STATESVILLE, NC 28687

LOCATION NC 115 N, TR S. CHIPLEY FORD RD, TR FOR DOBBS RD, TL DOBBS DRIVE, 4TH LOT ON LEFT

SUBDIVISION FT. DOBBS FARMS BLOCK / SECTION LOT 12 LOT AREA 130'X 250' SITE CLASS PS DESIGN FLOW 360 L.T.A.R. 0.30 GPD/FT²

Septic Tank: 1000 Gallons: STB Date 6-26-00
Pump Tank: Gallons; PT Date
Pump Make: Model Serial No.
Nitrification Field: No Fields 1 Square Feet EQ. TO 1200 Linear Feet 300
No Lines FOUR Trench Width 36" Max Trench Bottom Depth 36" Depth SAND 6"

☒ New System ☐ Repair System Type: I, II, (III), V, VI
System Description: 25% REDUCTION GRAVITY
Repair System Description: 50% REDUCTION PUMP
Maintenance Agreement Required: ☐ Yes ☒ No
☐ Slab ☒ Crawl Space ☐ Basement w/plumbing ☐ Basement wo/plumbing


☒ House/Mod. Home No. Bedrooms 3
☐ Mobile Home No. Bathrooms 2
☐ Business No. Employees
☐ Other

Water Supply: ☐ Individual ☒ Public ☐ Community


Comments:/Conditions: INSTALL 25% REDUCTION SYSTEM USING FIFTY (50) CHAMBERS (AT REQUEST)

Comments:/Conditions

INITIAL SITE SKETCH

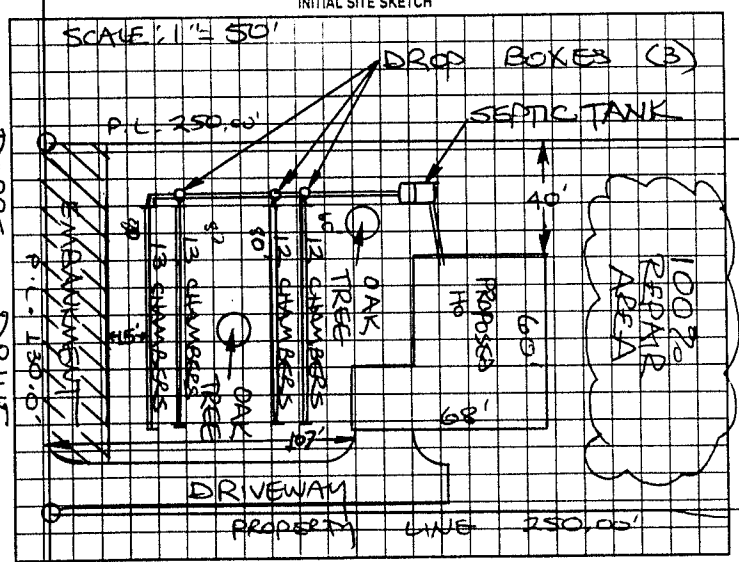

AS BUILT SKETCH

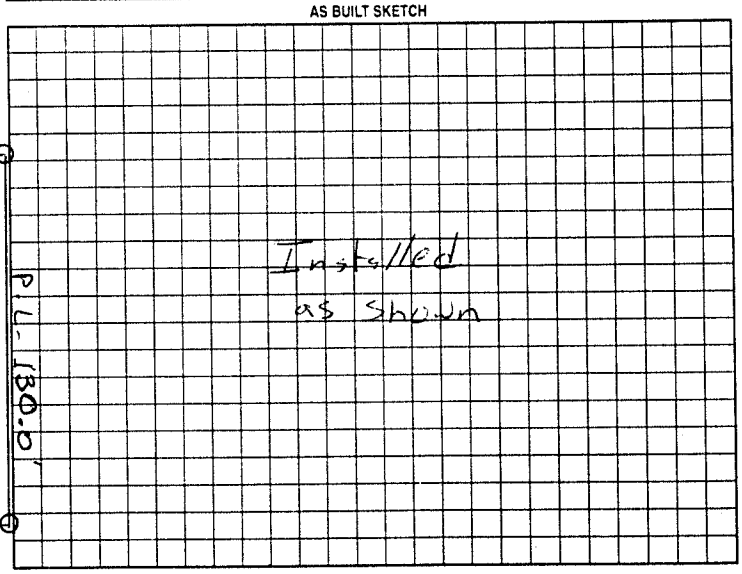

Permit can be suspended or revoked if any false information is supplied toward securing the permit/any unauthorized changes are made to the site/any unauthorized changes are made in the installation of the system. Improvement Permit with plat valid without expiration. Improvement Permit with site plan valid for sixty months. Authorization to Construct is valid for a period equal to that of Improvement Permit – not to exceed sixty months.

Signed: Lou Earnhardt date 5/16/00 Installed by: Craig Thompson

Improvement Permit by: STEVE HEDRICK date 5-13-2000 Operation Permit by: [illegible] date 9-29-00

Authorization to Construct by: STEVE HEDRICK date 5-13-2000 Existing System Inspection by: date

HEALTH DEPT COPY: WHITE OWNER COPY (FINAL): YELLOW OWNER COPY (INITIAL): PINK