IREDELL COUNTY HEALTH DEPARTMENT

STATESVILLE 704-878-5305 (A) MOORESVILLE 704-664-5281

IMPROVEMENT PERMIT / AUTHORIZATION TO CONSTRUCT / OPERATION PERMIT / EXISTING SYSTEM INSPECTION

PERMIT# 123554 / 27074 PIN# 4736-50-2908 DATE 2-24-05

OWNER OR CONTRACTOR DAVID MEEHAN PHONE: Business (704) 902-0286 Home

ADDRESS 105 GALAX DRIVE STATESVILLE NC 28677

LOCATION HWY 115 N TR CHIPLEY FORD RD TR FORT DOBBS RD TL DOBBS DR. LOT ON LEFT

SUBDIVISION FORT DOBBS FARMS BLOCK / SECTION LOT 13 LOT AREA 0.78 SITE CLASS. PS DESIGN FLOW 360 L.T.A.R. 0.30 gpd/ft²

Septic Tank: 1000 Gallons; STB 760 Date 11-30-04
Pump Tank: Gallons; PT Date
Pump Make: Model Serial No.
Nitrification Field: No Fields 1 Square Feet 1200 Linear Feet 300
No Lines 4 Trench Width 36" Max Trench Bottom Depth 24" Gravel Depth N/A

☑ New System ☐ Repair System Type: I, II, (III), IV, V, VI
System Description: GRAVITY 25% REDUCTION
Repair System Description: PUMP CONVENTIONAL
Maintenance Agreement Required: ☐ Yes ☑ No

☑ House/Mod. Home No. Bedrooms 3
☐ Mobile Home No. Bathrooms
☐ Business No. Employees
☐ Other


☐ Slab ☑ Crawl Space ☐ Basement w/plumbing ☐ Basement wo/plumbing

Water Supply: ☐ Individual ☑ Public ☐ Community


Comments/Conditions: ① INSTALL LINES 24" ON CONTOUR ② MAINTAIN SETBACKS ③ INSTALL PUBLIC WATER LINE AT LEAST 10' FROM DRAINFIELD ④ INSTALL FRENCH DRAIN 36" TO DAYLIGHT

Comments/Conditions: SEPTIC TANK WITH RISERS INSTALLED USING RED "Poly Lok" FILTER

INITIAL SITE SKETCH 1" = 40'

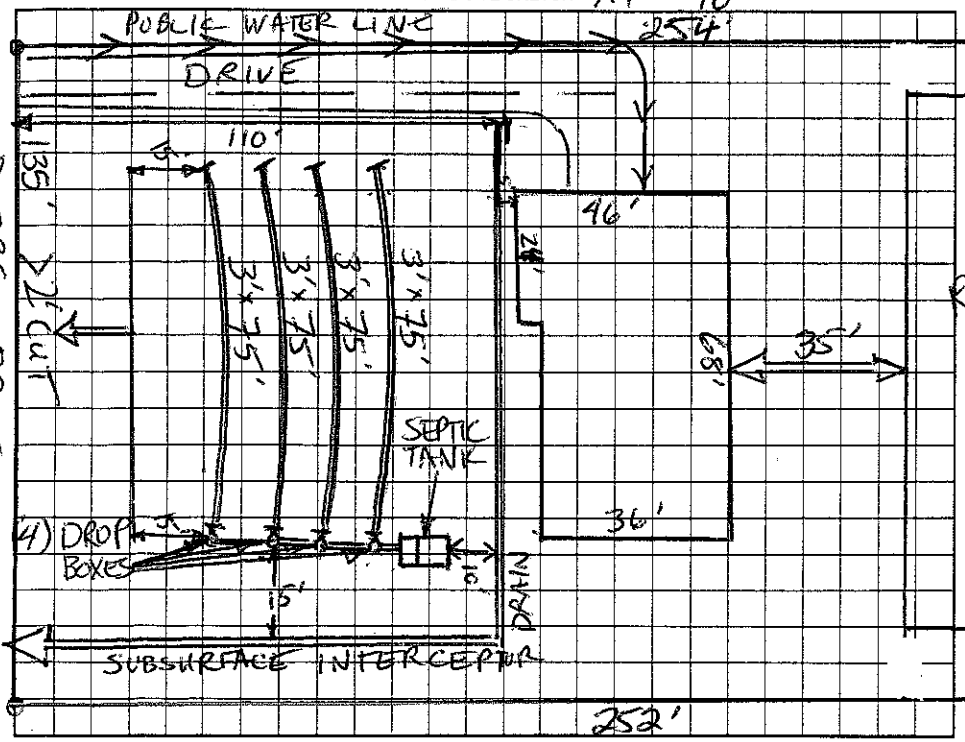

AS BUILT SKETCH

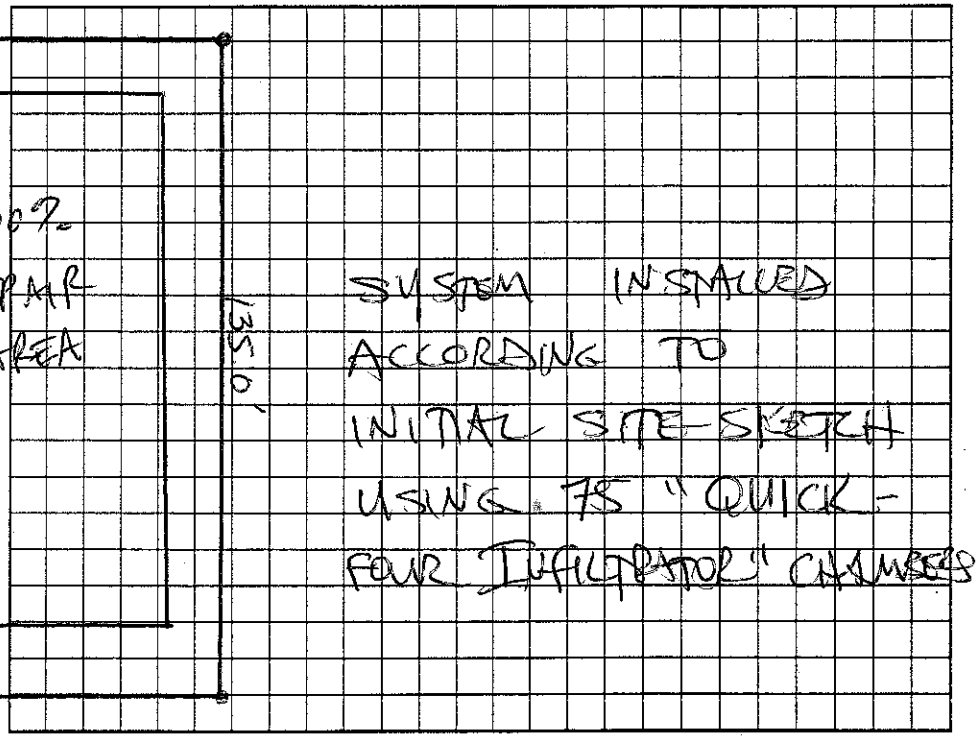

Permit can be suspended or revoked if any false information is supplied toward securing the permit/any unauthorized changes are made to the site/any unauthorized changes are made in the installation of the system. Improvement Permit with plat valid without expiration. Improvement Permit with site plan valid for sixty months. Authorization to Construct is valid for a period equal to that of Improvement Permit – not to exceed sixty months.

Signed: [signature] date 2-25-05 Installed by: BRENT GALLIHER

Improvement Permit by: [signature], LSS date 2-24-05 Operation Permit by: STEVE HENDRICK date 6-10-05

Authorization to Construct by: [signature], LSS date 2-24-05 Existing System Inspection by: date

HEALTH DEPT. COPY: WHITE OWNER COPY (FINAL): YELLOW OWNER COPY (INITIAL): PINK