IREDELL COUNTY HEALTH DEPARTMENT

STATESVILLE 704-878-5305 MOORESVILLE 704-664-5281

IMPROVEMENT PERMIT / AUTHORIZATION TO CONSTRUCT / OPERATION PERMIT / EXISTING SYSTEM INSPECTION

PERMIT# 80639 PIN# 4736503200 DATE 4-22-99

OWNER OR CONTRACTOR Charles Nantz PHONE: Business Home 872 4749

ADDRESS 491 Fort Dobbs Rd Statesville, N.C.

LOCATION 115 TR Chipley Ford at corner of, Fort Dobbs Rd

SUBDIVISION Dobbsview BLOCK / SECTION LOT 8 LOT AREA 1.29 acres SITE CLASS PS DESIGN FLOW 360 L.T.A.R. .35

Septic Tank: 1000 Gallons; STB 1012 Date 8-9-99

~~Pump Tank:~~ Gallons; PT Date

Pump Make: Model Serial No.

Nitrification Field: No Fields 1 Square Feet 1050 Linear Feet 350

No Lines 5 Trench Width 36" Max Trench Bottom Depth 36" Gravel Depth 12"

☑ New System ☐ Repair System Type: I II III IV V

System Description: Conv. Gravity

~~Repair System Description:~~

Maintenance Agreement Required: ☐ Yes ☑ No

☑ House/Mod. Home No. Bedrooms 3

☐ Mobile Home No. Bathrooms 2

☐ Business No. Employees

☐ Other


☐ Slab ☐ Crawl Space ☐ Basement w/plumbing ☐ Basement wo/plumbing

Water Supply: ☐ Individual ☑ Public ☐ Community

Comments/Conditions:

Comments/Conditions:

INITIAL SITE SKETCH

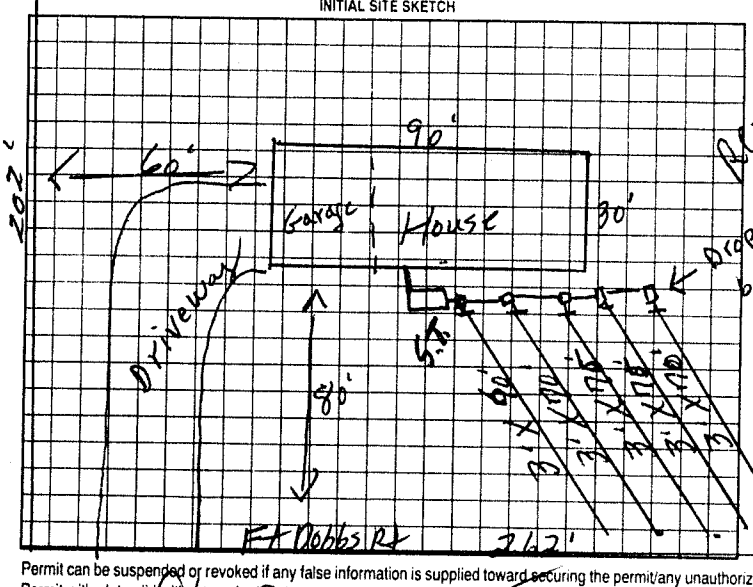

AS BUILT SKETCH

Same as initial sketch except house was shifted up hill & shown on sketch was same system

Permit can be suspended or revoked if any false information is supplied toward securing the permit/any unauthorized changes are made to the site/any unauthorized changes are made in the installation of the system. Improvement Permit with plat valid without expiration. Improvement Permit with site plan valid for sixty months. Authorization to Construct is valid for a period equal to that of Improvement Permit – not to exceed sixty months.

Signed: X date Installed by: Tommy Fryr

Improvement Permit by: R. C. Moore date 4-22-99 Operation Permit by: R. C. Moore date 10-25-99

Authorization to Construct by: R. C. Moore date 4-22-99 Existing System Inspection by: date

HEALTH DEPT. COPY WHITE OWNER COPY (FINAL) YELLOW OWNER COPY (INITIAL) PINK