IREDELL COUNTY HEALTH DEPARTMENT

Statesville Office (704) 878-5305 Mooresville Office (704) 660-3625 PERMIT # 221983

IMPROVEMENT PERMIT / AUTHORIZATION TO CONSTRUCT / OPERATION PERMIT / EXISTING SYSTEM

PIN # 4736503777

APPLICANT: Teresa Kirkendall APPLICANT ADDRESS: 127 Dobbs Dr Statesville NC

SITE ADDRESS: 127 Dobbs Dr Statesville NC PHONE: 704-728-2556 ALT. PHONE: N/A

SITE DIRECTIONS: 115 N T/R S. Chipley Ford Rd T/R Fort Dobbs Rd T/L Dobbs Dr 3rd house on left

SUBDIVISION: Fort Dobbs Farms SECTION: N/A LOT # 11 LOT AREA: 0.8ac DESIGN FLOW: 360 L.T.A.R.: Ex

Septic Tank 1000 (gal) STB 760 Date 7/10/16
Pump Tank (gal) PT Date
Pump Make Model Serial #
Nitrification Fields Ex # Lines Ex Linear Ft: Ex
Trench Width Ex Max. Trench Bottom Depth Ex Gravel Depth Ex


☐ New System ☒ Repair ☐ Expansion System Type: I II III IV V VI
System Description: Tank
Repair System Description:
Maintenance Agreement Required: ☐ YES ☒ NO
☒ GRAVITY ☐ PRESSURE

☒ Residence No. Bedrooms 3
☐ Business No. Persons 6
☐ Other No. Employees
☐ Slab ☒ Crawl Space
☐ Basement w/plumbing ☐ Basement w/o plumbing

Water Supply: ☐ Private ☒ Public ☐ Community


Comments / Conditions: Pump, crush + fill existing tank

INITIAL SITE SKETCH

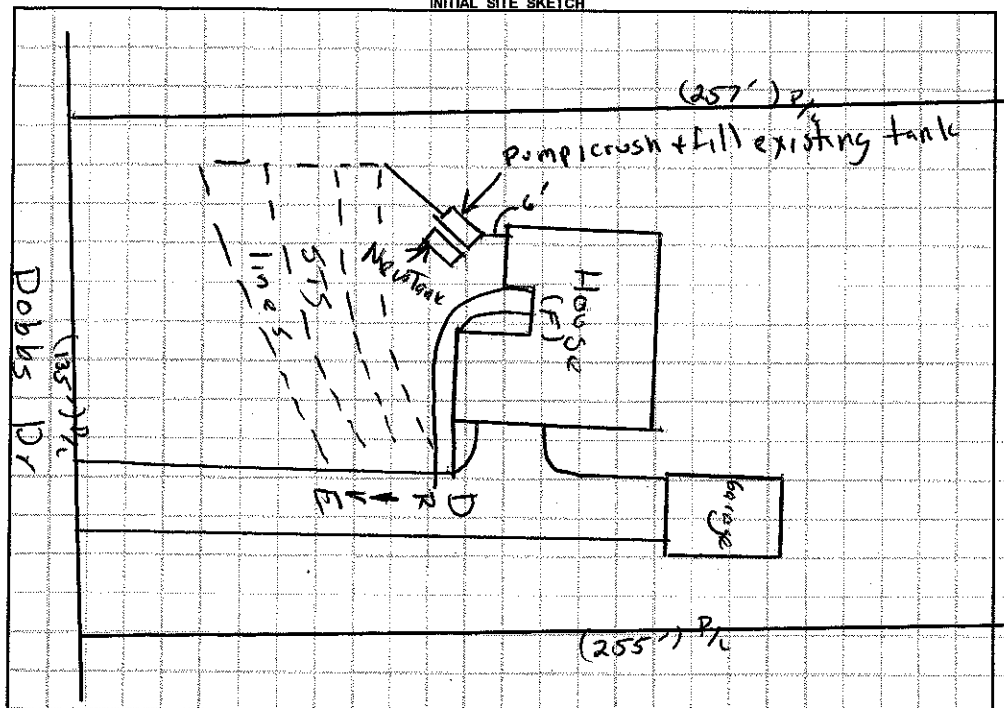

AS BUILT SKETCH

1" = 50'

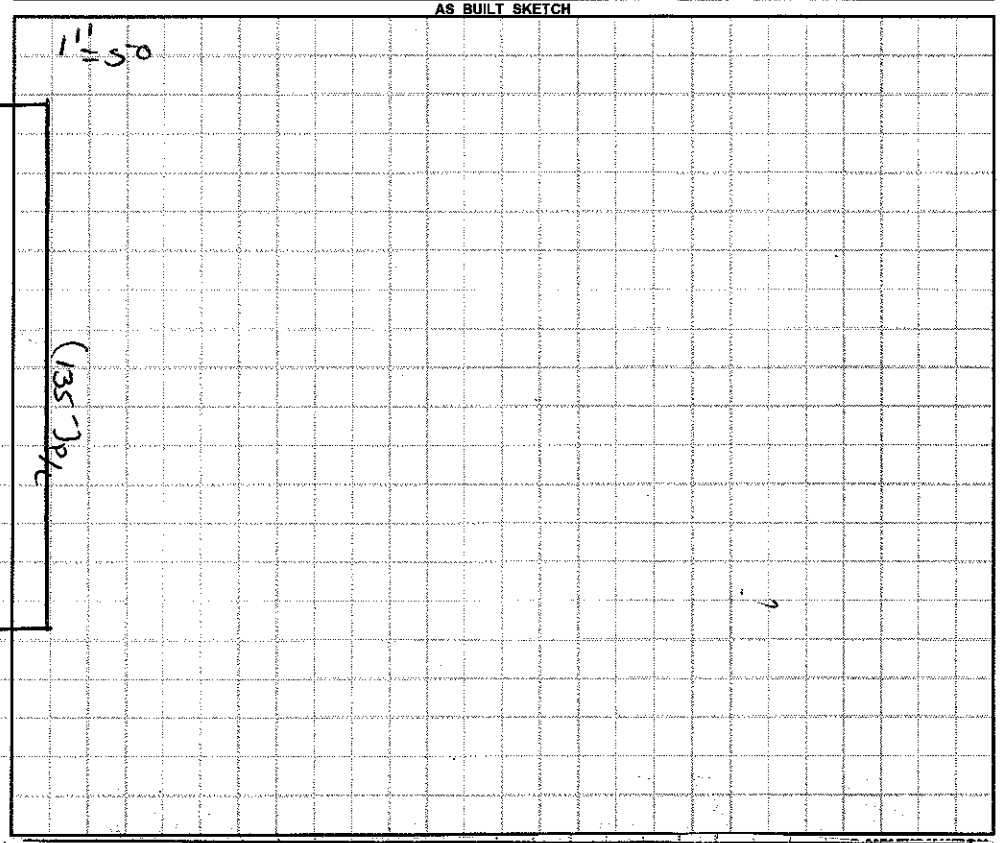

Permit can be suspended or revoked if any false information is supplied toward securing the permit / any unauthorized changes are made to the site / any unauthorized changes are made in the installation of this system. **CONTACT A LOCATOR SERVICE PRIOR TO ANY EXCAVATION**

☐ **IMPROVEMENT PERMIT** *with plat* valid without expiration. ☒ **IMPROVEMENT PERMIT** *with site plan* valid for 60 mos. ☒ **AUTHORIZATION TO CONSTRUCT** valid for period equal to IMPROVEMENT PERMIT--not to exceed 60 mo.

Owner / Applicant Signature: Date: 9/27/16 Installed by:

IMPROVEMENT PERMIT by: Date: 09/26/16 OPERATION PERMIT by: 9/27/16

AUTHORIZATION TO CONSTRUCT by: Date: 09/26/16 Existing System Inspected by: Date:

Health Dept. Copy - WHITE Applicant (Final Approval I) - YELLOW Applicant (Conditional Approval) - PINK