IREDELL COUNTY HEALTH DEPARTMENT

STATESVILLE 704-878-5305 MOORESVILLE 704-664-5281

IMPROVEMENT PERMIT / CERTIFICATE OF COMPLETION / OPERATION PERMIT / EXISTING SYSTEM INSPECTION

PROPERTY DESCRIPTION NO. 065690 DATE 3-31-97 TAX MAP NO. Pin No. 4736504499 Watershed: ☐ Yes ☐ No

OWNER OR CONTRACTOR Ed Maylowe PHONE: Business Home 704-872-4111

ADDRESS 1120 Barkley Rd Statesville, N.C.

LOCATION 115N TR South Chipley Rd TR Ft Dobbs Rd Jb Dobbs Loop 1st lot 140ft

SUBDIVISION Ft Dobbs Fm BLOCK / SECTION LOT 9 LOT AREA approx lume SITE CLASS. P5 DESIGN FLOW 360 L.T.A.R. .33

Septic Tank: 1000 Gallons; STB 102 Date 7-8-97

Pump Tank: Gallons; PT Date

Pump Make: Model Serial No.

Nitrification Field: No Fields 1 Square Feet 810 Linear Feet 270

No Lines 3 Trench Width 36" Max Trench Bottom Depth 36" Gravel Depth N/A

☑ New System ☐ Repair System Type: I, II, III, IV, V, VI

System Description: Gravity/Chambers

Repair System Description: " "

Maintenance Agreement Required: ☐ Yes ☑ No

☑ House/Mod. Home No. Bedrooms 3

☐ Mobile Home No. Bathrooms 2

☐ Business No. Employees


☐ Other

☐ Slab ☐ Crawl Space ☐ Basement w/plumbing ☐ Basement wo/plumbing

Water Supply: ☐ Individual ☐ Community ☑ Public


Comments:

INITIAL SITE SKETCH

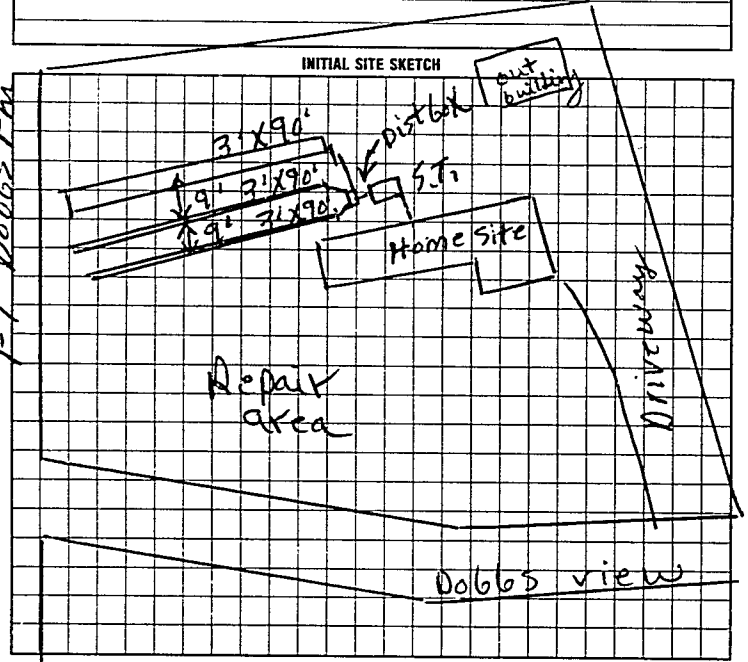

Comments: ACD
* Installer & Homeowner verified flag + layout

AS-BUILT SKETCH

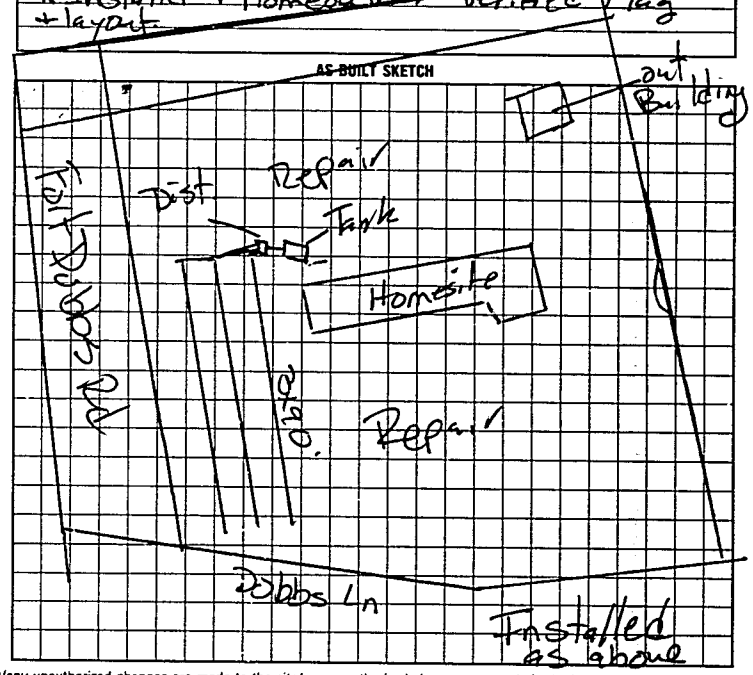

I understand that this permit can be suspended or revoked if any false information is supplied toward securing the permit/any unauthorized changes are made to the site/any unauthorized changes are made in the installation of the system. Improvement Permit is valid for 60 months from date of issuance.

Signed:

Improvement Permit by: P.C. Moore date 3-31-97

Authorization Existing System Inspection by: P.C. Moore date 3-31-97

to cont

Installed by: Arnie Duncan

Certificate of Completion by: date

Operation Permit by: Mary C Outlaw RS date 10-1-97

HEALTH DEPT. COPY: WHITE INSPECTION COPY (FINAL): GREEN OWNER COPY (FINAL): YELLOW INSPECTION COPY (INITIAL): PINK OWNER COPY (INITIAL): GOLD

Authorization to cont Expires 60 mos from issue

6 2 7 1 0 0