The location of the proposed enclosed porch addition does not appear to impact the existing septic system.
**NOTE:

REHS
Date: 1-26-11
CHD-Environmental Health Division

IREDELL COUNTY HEALTH DEPARTMENT

STATESVILLE 704-878-5305 MOORESVILLE 704-664-5281

IMPROVEMENT PERMIT / CERTIFICATE OF COMPLETION / OPERATION PERMIT / EXISTING SYSTEM INSPECTION

PROPERTY DESCRIPTION NO. 24790 DATE 9-11-96 TAX MAP NO. 100-2-A-20 Watershed: [ ] Yes [X] No
OWNER OR CONTRACTOR Joe Davidson PHONE: Business Home
ADDRESS 524 E Broad St. Statesville N.C.
LOCATION S Chipley Ford Rd TR Ft Dobbs Rd TL Dobbs Drive 3rd lot on rt
SUBDIVISION Ft Dobbs BLOCK / SECTION LOT 20 LOT AREA .88 acres SITE CLASS. RS DESIGN FLOW 480 L.T.A.R. .3

Septic Tank: 1000 Gallons; STB 1012 Date 11-6-99
Pump Tank: Gallons; PT Date
Pump Make: Model Serial No.
Nitrification Field: No Fields 1 Square Feet 1200 Linear Feet 400
No Lines 5 Trench Width 36" Max Trench Bottom Depth 36" Gravel Depth N/A

[ ] New System [ ] Repair System Type: I, II, III, IV, V
System Description: Chambers Gravity
Repair System Description: Chambers Pump
Maintenance Agreement Required: [ ] Yes [ ] No


[ ] House/Mod. Home No. Bedrooms 4
[ ] Mobile Home No. Bathrooms 2½
[ ] Business No. Employees
[ ] Other
[ ] Slab [ ] Crawl Space [X] Basement w/plumbing [ ] Basement wo/plumbing

Water Supply: [ ] Individual [ ] Community [X] Public


Comments:

Comments:

INITIAL SITE SKETCH

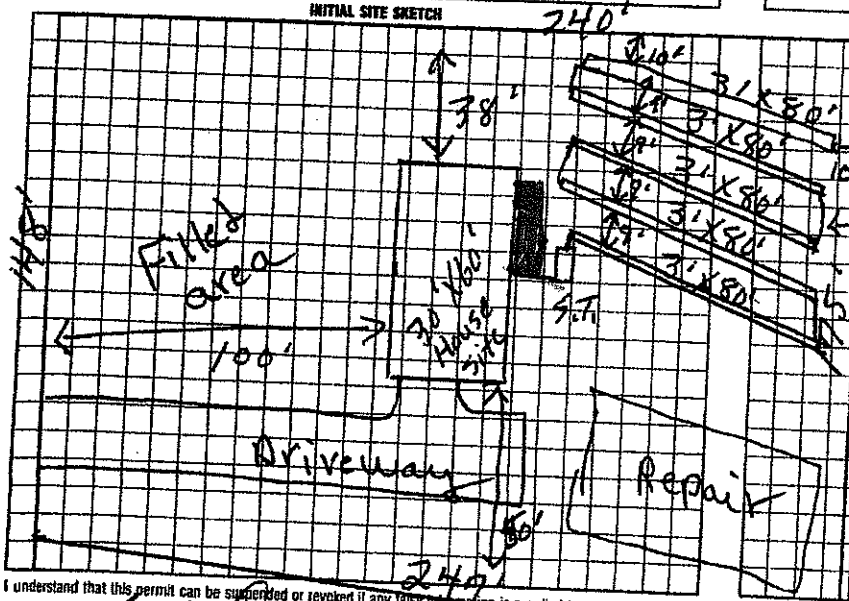

AS BUILT SKETCH

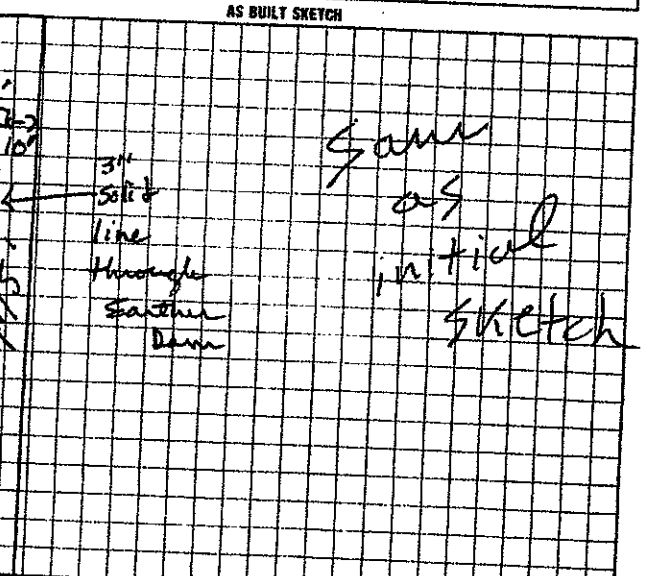

I understand that this permit can be suspended or revoked if any false information is supplied toward securing the permit/any unauthorized changes are made to the site/any unauthorized changes are made in the installation of the system.

Signed: X Joe Davidson

Improvement Permit by: E.C. Moore date 9-11-96
Existing System Evaluation by: E.C. Moore date 9-11-96
Authorization to cover

Installed by: Craig Thompson
Certificate of Completion by: date
Operation Permit by: E.C. Moore date 9-15-99
Expires 60 mos from issue

HEALTH DEPT. COPY: WHITE INSPECTION COPY (FINAL): GREEN OWNER COPY (FINAL): YELLOW INSPECTION COPY (INITIAL): PINK OWNER COPY (INITIAL): GOLD