IREDELL COUNTY HEALTH DEPARTMENT

STATESVILLE 704-878-5305 MOORESVILLE 704-664-5281

53501

IMPROVEMENT PERMIT / CERTIFICATE OF COMPLETION / OPERATION PERMIT / EXISTING SYSTEM INSPECTION

PROPERTY DESCRIPTION NO. 17763 DATE 2-21-94 TAX MAP NO. 10C 8- A- Watershed. ☐ Yes ☑ No

OWNER OR CONTRACTOR Gregg Henderson PHONE: Business 872-1347 Home 873-5778

ADDRESS 507 Millsaps Rd Statesville N.C. 28677

LOCATION Chipley Ford Rd TR Ft Dobbs 560' on Rt.

SUBDIVISION Dobbs view BLOCK / SECTION ____ LOT ~~Lot~~ 5 LOT AREA 1.0 acre SITE CLASS. PS DESIGN FLOW 360 L.T.A.R. .35

Septic Tank: 1000 Gallons; STB 794 Date 3-31-95

Pump Tank: ____ Gallons; PT ____ Date ____

Pump Make: ____ Model ____ Serial No. ____

Nitrification Field: No. Units 1 Square Feet 1035 Linear Feet 345

No Lines 3 Trench Width 36" Max Trench Bottom Depth 36" Gravel Depth 12"

☑ New System ☐ Repair System Type: I (II) III, IV, V, VI

System Description: Conv. Gravity

Repair System Description: " "

Maintenance Agreement Required: ☐ Yes ☑ No

☑ House/Mod. Home ☐ Mobile Home ☐ Business ☐ Other

No. Bedrooms 3 No. Bathrooms 2 No. Employees ____

☐ Slab ☐ Crawl Space ☑ Basement w/plumbing ☐ Basement wo/plumbing


Water Supply: ☐ Individual ☐ Community ☑ Public

Comments:


Comments:

Basement was deleted Therefore System did not have to be Placed 50' down slope

INITIAL SITE SKETCH

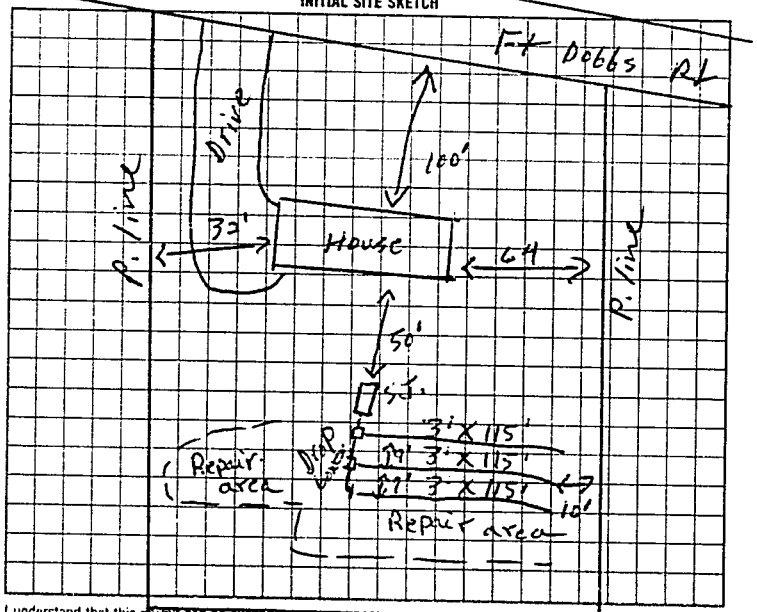

AS BUILT SKETCH

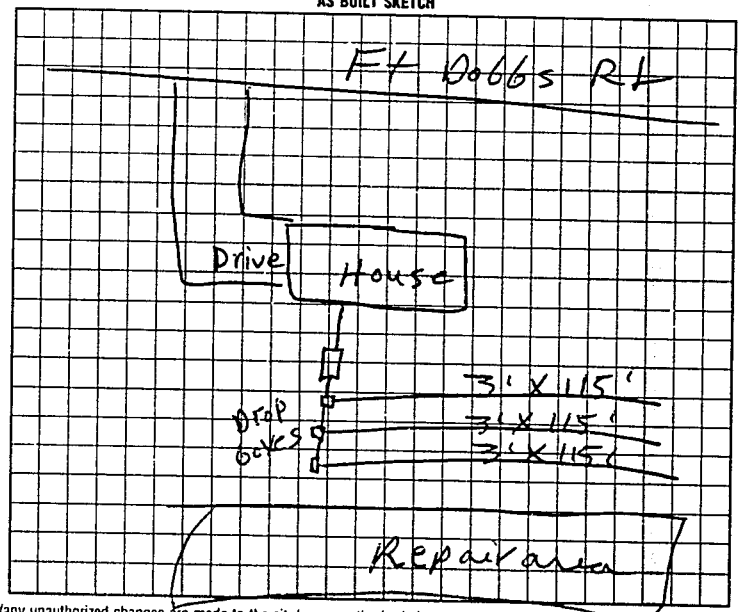

I understand that this permit can be suspended or revoked if any false information is supplied toward securing the permit/any unauthorized changes are made to the site/any unauthorized changes are made in the installation of the system. Improvement Permit is valid for 60 months from date of issuance.

Signed: x Gregg W Henderson

Improvement Permit by: J. C. Moore date 2-21-94

Existing System Inspection by: ____ date ____

Installed by: James Hutler

Certificate of Completion by: J. C. Moore date 6-14-95

Operation Permit by: ____ date ____

HEALTH DEPT. COPY: WHITE INSPECTION COPY (FINAL): GREEN OWNER COPY (FINAL): YELLOW INSPECTION COPY (INITIAL): PINK OWNER COPY (INITIAL): GOLD

