IREDELL COUNTY HEALTH DEPARTMENT

on Computer 2N-A-20 57548

STATESVILLE 704-878-5305 MOORESVILLE 704-564-5281

IMPROVEMENT PERMIT / CERTIFICATE OF COMPLETION / OPERATION PERMIT / EXISTING SYSTEM INSPECTION

PROPERTY DESCRIPTION NO. 22113 DATE 9-12-95 TAX MAP NO. 10D-2-A-19 Watershed: ☐ Yes ☑ No

OWNER OR CONTRACTOR J. TODD ELLIS PHONE: Business Home 878-6633

ADDRESS 178 MEADOW OAKS DR. STATESVILLE, NC 28677

LOCATION NC 115 N TR S. CHIPLEY FORD TR FT. DOBBS RD, ~~2ND LOT ON~~ TL DOBBS RD, 2ND ON (R)

SUBDIVISION FT. DOBBS FARMS BLOCK / SECTION LOT 19 LOT AREA 1.2 ACRES SITE CLASS. PS DESIGN FLOW 480 L.T.A.R. 0.35 GPD/FT²

Septic Tank: 1000 Gallons; STB 1012 Date 12-17-95

Pump Tank: Gallons; PT Date

Pump Make: Model Serial No.

Nitrification Field: No Fields Square Feet 1380 Linear Feet 460

No Lines 5 Trench Width 36" Max Trench Bottom Depth 18-36" Gravel Depth 12"

☑ New System ☐ Repair System Type: I II III IV V VI

System Description: CONV. GRAVITY

Repair System Description: CONV. GRAVITY

Maintenance Agreement Required: ☐ Yes ☑ No

☑ House/Mod. Home No. Bedrooms 4

☐ Mobile Home No. Bathrooms 2

☐ Business No. Employees

☐ Other


☐ Slab ☑ Crawl Space ☐ Basement w/plumbing ☐ Basement wo/plumbing

Water Supply: ☐ Individual ☐ Community ☑ Public

Comments:

Comments:

INITIAL SITE SKETCH

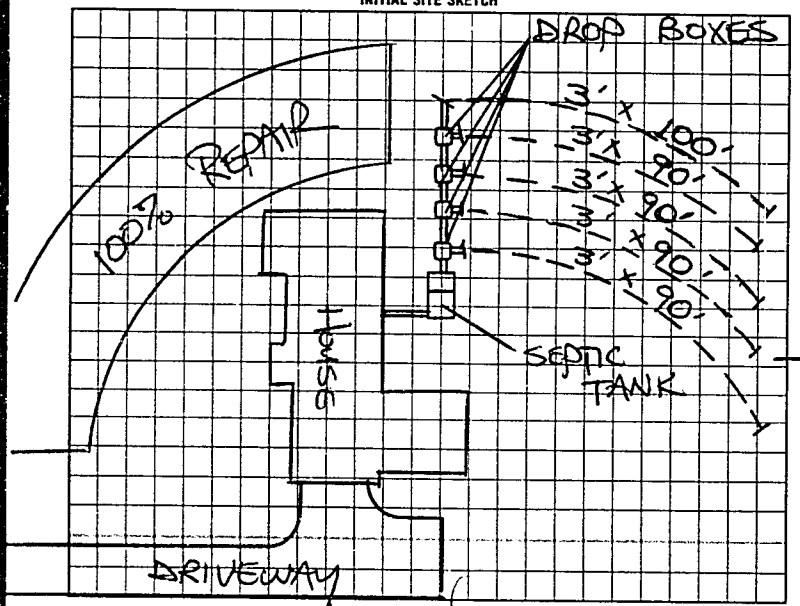

AS BUILT SKETCH

SYSTEM INSTALLED ACCORDING TO INITAL SITE SKETCH

I understand that this permit can be suspended or revoked if any false information is supplied toward securing the permit/any unauthorized changes are made to the site/any unauthorized changes are made in the installation of the system.

Signed: X

Improvement Permit by: STEVE HENDRICK date 9-12-95

Existing System Inspection by: date

Installed by: DAVID YOUNTZ

Certificate of Completion by: date

Operation Permit by: STEVE HENDRICK date 3-14-96

HEALTH DEPT. COPY: WHITE INSPECTION COPY (FINAL): GREEN OWNER COPY (FINAL): YELLOW INSPECTION COPY (INITIAL): PINK OWNER COPY (INITIAL): GOLD