IREDELL COUNTY HEALTH DEPARTMENT

STATESVILLE 704-878-5305 MOORESVILLE 704-664-5281

IMPROVEMENT PERMIT / AUTHORIZATION TO CONSTRUCT / OPERATION PERMIT / EXISTING SYSTEM INSPECTION

PERMIT# 151309 PIN# ~~4636510939~~ 4736510939 DATE 7-22-08

OWNER OR APPLICANT Samuel G. Scott Contracting Co. Inc. PHONE: Business 704 902 3230 Home

ADDRESS 137 Twin Lakes Dr.

LOCATION Hwy 115N, R on Chipley Ford Rd. R Twin Lakes Dr. property on left past second home on street

SUBDIVISION Fort Dobbs Farms BLOCK / SECTION LOT 44 LOT AREA 1.525 Ac. SITE CLASS P3 DESIGN FLOW 600 L.T.A.R. .3

Septic Tank: 1500 Gallons; STB 528 Date 11-17-08

Pump Tank: Gallons; PT Date

Pump Make: Model Serial No.

Nitrification Field: No Fields 1 Square Feet 2000 Linear Feet 500

No Lines 4 Trench Width 36" Max Trench Bottom Depth 36" Gravel Depth

■ New System ☐ Repair ☐ Expansion System Type: I II III IV V VI

System Description: 25% Reduction Gravity

Repair System Description: 25% Reduction Gravity

Maintenance Agreement Required: ☐ Yes ■ No

■ House/Mod. Home ☐ Mobile Home ☐ Business ☐ Other

No. Bedrooms 5 No. Persons No. Employees

Water Supply: ■ Individual ☐ Public ☐ Community


■ Gravity ☐ Pressure ☐ Slab ☐ Crawl Space ■ Basement w/plumbing ☐ Basement wo/plumbing

Comments:/Conditions:


(4) 3' x 125'

Comments:/Conditions:

INITIAL SITE SKETCH

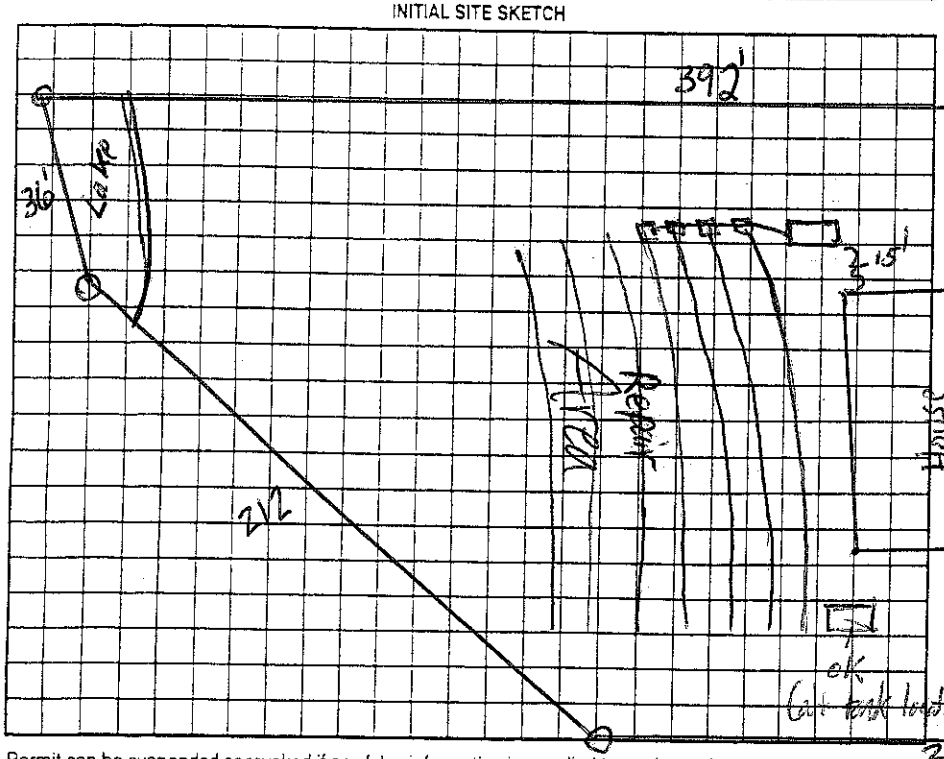

AS BUILT SKETCH

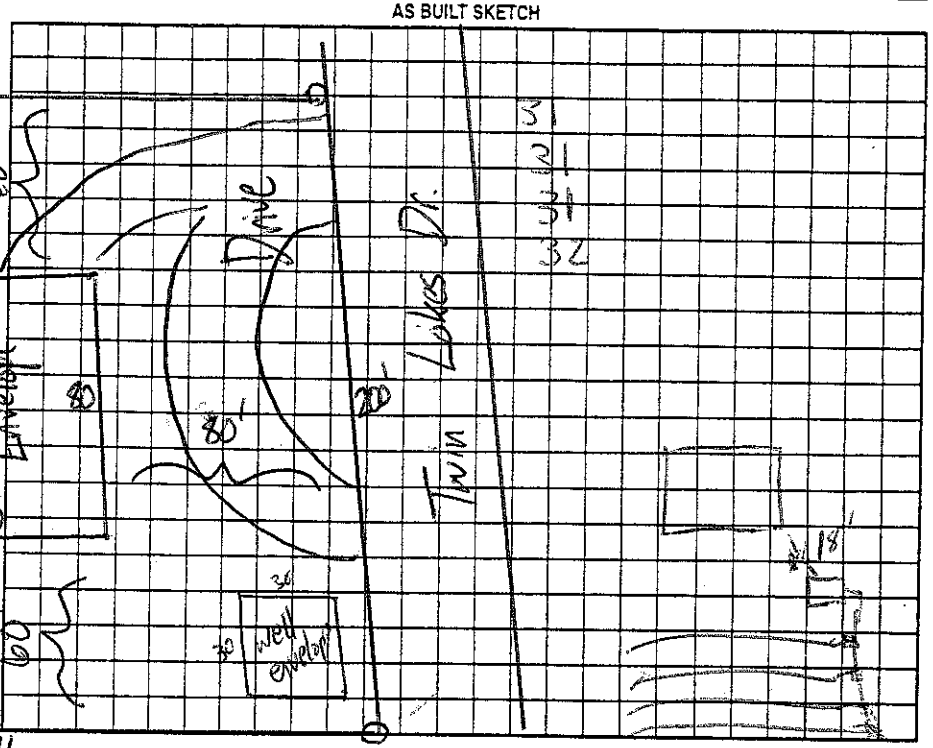

Permit can be suspended or revoked if any false information is supplied toward securing the permit/any unauthorized changes are made to the site/any unauthorized changes are made in the installation of the system. Improvement Permit with plat valid without expiration ☐ Improvement Permit with site plan valid for sixty months ■ Authorization to Construct is valid for a period equal to that of Improvement Permit – not to exceed sixty months.

Signed: date 7-22-08 Installed by: Younts Grading

Improvement Permit by: date 7-22-08 Operation Permit by: date 2-6-9

Authorization to Construct by: date 7-22-08 Existing System Inspection by: date

HEALTH DEPT. COPY: WHITE OWNER COPY (FINAL): YELLOW OWNER COPY (INITIAL): PINK