IREDELL COUNTY HEALTH DEPARTMENT

#059208

STATESVILLE 704-878-5305 MOORESVILLE 704-664-5281

IMPROVEMENT PERMIT / CERTIFICATE OF COMPLETION / OPERATION PERMIT / EXISTING SYSTEM INSPECTION

PROPERTY DESCRIPTION NO 22962 DATE 1-30-96 TAX MAP NO 10D-2-A-31

OWNER OR CONTRACTOR TERRY LUTHER PHONE: Business BILLY SELF — Home → 873-9612 Watershed: ☐ Yes ☑ No

ADDRESS c/o P.O BOX 1283, STVL, NC 28687

LOCATION US 21 N TL FORT DOBBS ROAD, TR DOBBS DRIVE, LOT AT END ON RIGHT

SUBDIVISION FORT DOBBS BLOCK / SECTION LOT 31 LOT AREA 2.163 AC SITE CLASS PS DESIGN FLOW 360 L.T.A.R. 0.33 GPD/FT²

Septic Tank: 1000 Gallons; STB FOTZ Date 7-2-96
Pump Tank: Gallons; PT Date
Pump Make: Model Serial No 480
Nitrification Field No Fields 1 Square Feet 1080 Linear Feet 360
No Lines 3 4 Trench Width 36" Max Trench Bottom Depth 18-36" Gravel Depth 12"

☑ New System Repair System Type: I II III IV V
System Description: CONVENTIONAL GRAVITY
Repair System Description CONV. GRAVITY
Maintenance Agreement Required Yes ☑ No


☑ House/Mod. Home No Bedrooms 3
Mobile Home No Bathrooms 2½
Business No Employees
Other 4 BR

☑ Slab ☐ Crawl Space ☑ Basement w/plumbing ☑ Basement wo/plumbing

Water Supply
☐ Individual
☐ Community
☑ Public

Comments:

Comments
SYSTEM CHANGED TO ACCOMODATE 4 BEDROOM HOUSE

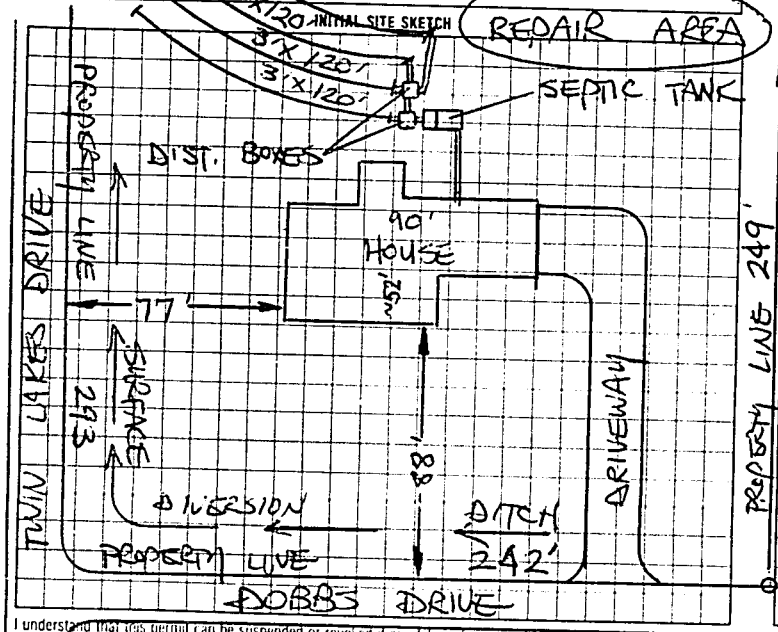

AS BUILT SKETCH

SYSTEM INSPECTED ACCORDING TO INITIAL SITE SKETCH

I understand that this permit can be suspended or revoked if any false information is supplied toward securing the permit, any unauthorized changes are made to the site, any unauthorized changes are made in the installation of the system

Signed X SELF HOMES, INC. BY: V. PRESIDENT AUTHORIZATION TO CONSTRUCT IS VALID FIVE (5) YEARS FROM DATE OF ISSUANCE - IMPROVEMENT PERMIT HAS NO EXPIRATION DATE

Improvement Permit by STEVE HENDRICK date 1-30-96 Installed by DAVID YOUNTZ

AUTHORIZATION TO CONSTRUCT Checking System Inspection by STEVE HENDRICK date 1-30-96 Certificate of Completion by date

Operation Permit by STEVE HENDRICK date 9-24-96

HEALTH DEPT. COPY (WHITE) INSPECTION COPY (INITIAL) (PINK) OWNER COPY (PINK) YELLOW INSPECTION COPY (FINAL) (BLUE)