55510

IREDELL COUNTY HEALTH DEPARTMENT

STATESVILLE 704-878-5305 MOORESVILLE 704-664-5281

IMPROVEMENT PERMIT / CERTIFICATE OF COMPLETION / OPERATION PERMIT / EXISTING SYSTEM INSPECTION

PROPERTY DESCRIPTION NO. 20870 DATE 4-13-95 TAX MAP NO. 100-2-A-30 Watershed: ☐ Yes ☑ No

OWNER OR CONTRACTOR T. Todd Ellis PHONE: Business Home 878 6633

ADDRESS 110 St. Paul Rd Statesville

LOCATION Chipley Ford Rd TR Twin Lakes Rd TR Dobbs Dr 2nd lot left

SUBDIVISION Ft Dobbs Fm. BLOCK / SECTION LOT 30 LOT AREA 150'X245' SITE CLASS. PS DESIGN FLOW 360 L.T.A.R. .34

Septic Tank: 1000 Gallons; STB 1012 Date 4-24-95

Pump Tank: Gallons; PT Date

Pump Make: Model Serial No.

Nitrification Field: No Fields 1 Square Feet 1080 Linear Feet 360

No Lines 4 Trench Width 36" Max Trench Bottom Depth 36" Gravel Depth 12"

☑ New System ☐ Repair System Type: I, II, III, IV, V, VI

System Description: Conv. Gravity

Repair System Description: " "

Maintenance Agreement Required: ☐ Yes ☑ No

☐ Slab ☑ Crawl Space ☐ Basement w/plumbing ☐ Basement wo/plumbing

☑ House/Mod. Home No. Bedrooms 3

☐ Mobile Home No. Bathrooms 2

☐ Business No. Employees


☐ Other

Water Supply: ☐ Individual ☐ Community ☑ Public

Comments:

150'

INITIAL SITE SKETCH

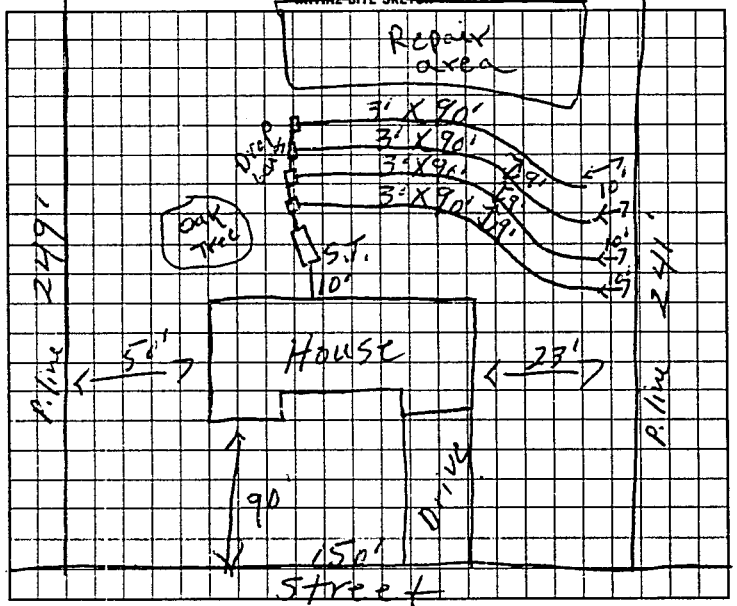

AS BUILT SKETCH

Same as initial sketch

I understand that this permit can be suspended or revoked if any false information is supplied toward securing the permit/any unauthorized changes are made to the site/any unauthorized changes are made in the installation of the system. Improvement Permit is valid for 60 months from date of issuance.

Signed: X

Improvement Permit by: R. C. Moore date 4-13-95

Existing System Inspection by: date

Installed by: Eddie Yountz & Sons

Certificate of Completion by: R. C. Moore date 7-27-95

Operation Permit by: date

HEALTH DEPT. COPY: WHITE INSPECTION COPY (FINAL): GREEN OWNER COPY (FINAL): YELLOW INSPECTION COPY (INITIAL): PINK OWNER COPY (INITIAL): GOLD