IREDELL COUNTY HEALTH DEPARTMENT

STATESVILLE 704-878-5305 MOORESVILLE 704-664-5281

IMPROVEMENT PERMIT / AUTHORIZATION TO CONSTRUCT / OPERATION PERMIT / EXISTING SYSTEM INSPECTION

PERMIT# 72883 PIN# 4765184184 DATE 4-30-98

OWNER OR CONTRACTOR Brian Souther PHONE: Business Home 592-5024

ADDRESS 126 Grassy Knob Rd Union Grove N.C.

LOCATION 21N TL Ft Dobbs TR Dobbsview TR Ft Valley Ct atens

SUBDIVISION Ft Dobbs Em. BLOCK / SECTION LOT 26 LOT AREA 2.8 acres SITE CLASS PS DESIGN FLOW 600 L.T.A.R. .133

Septic Tank: 1500 Gallons; STB 1011 Date 5-29-98

Pump Tank: Gallons; PT Date

Pump Make: Model Serial No.

Nitrification Field: No Fields 1 Square Feet 1800 Linear Feet 600

No Lines 24 Trench Width 36" Max Trench Bottom Depth 36" Gravel Depth 12"

☑ New System ☐ Repair System Type: I, II, III, IV, V, VI 450

System Description: Conv. Gravity

Repair System Description: " "

Maintenance Agreement Required: ☐ Yes ☑ No

☑ House/Mod. Home No. Bedrooms 5

☐ Mobile Home No. Bathrooms 3½

☐ Business No. Employees

☐ Other


☐ Slab ☑ Crawl Space ☑ Basement w/plumbing ☐ Basement wo/plumbing

Water Supply: ☐ Individual ☑ Public ☐ Community


Comments:/Conditions:

Comments:/Conditions:

INITIAL SITE SKETCH

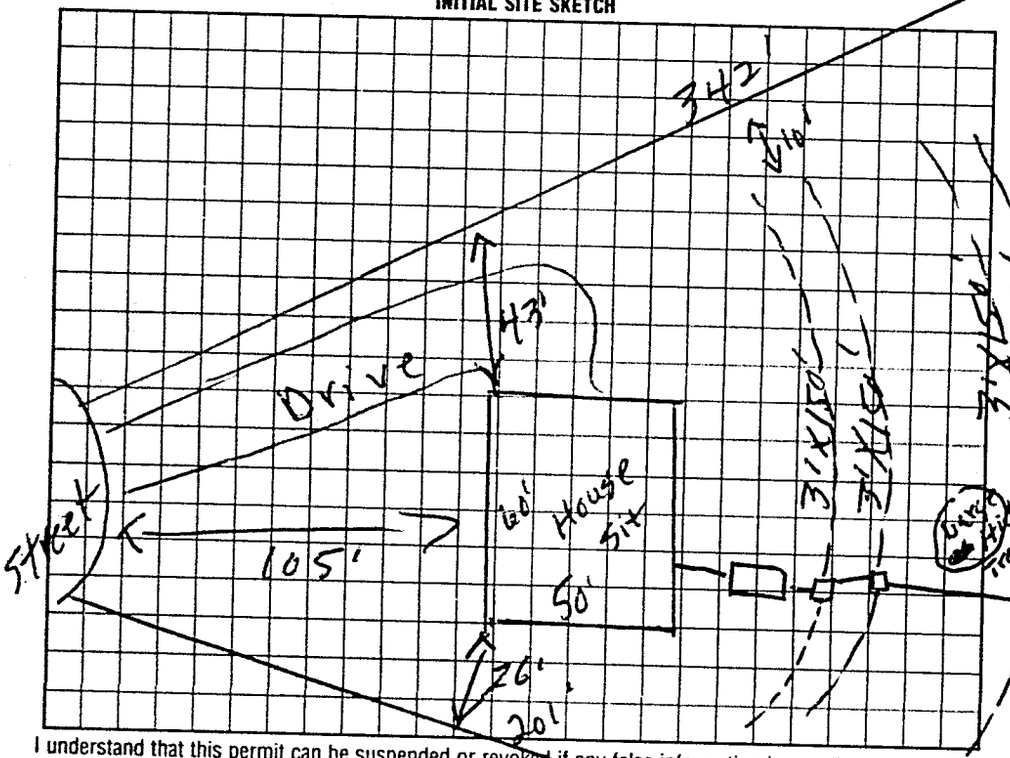

AS BUILT SKETCH

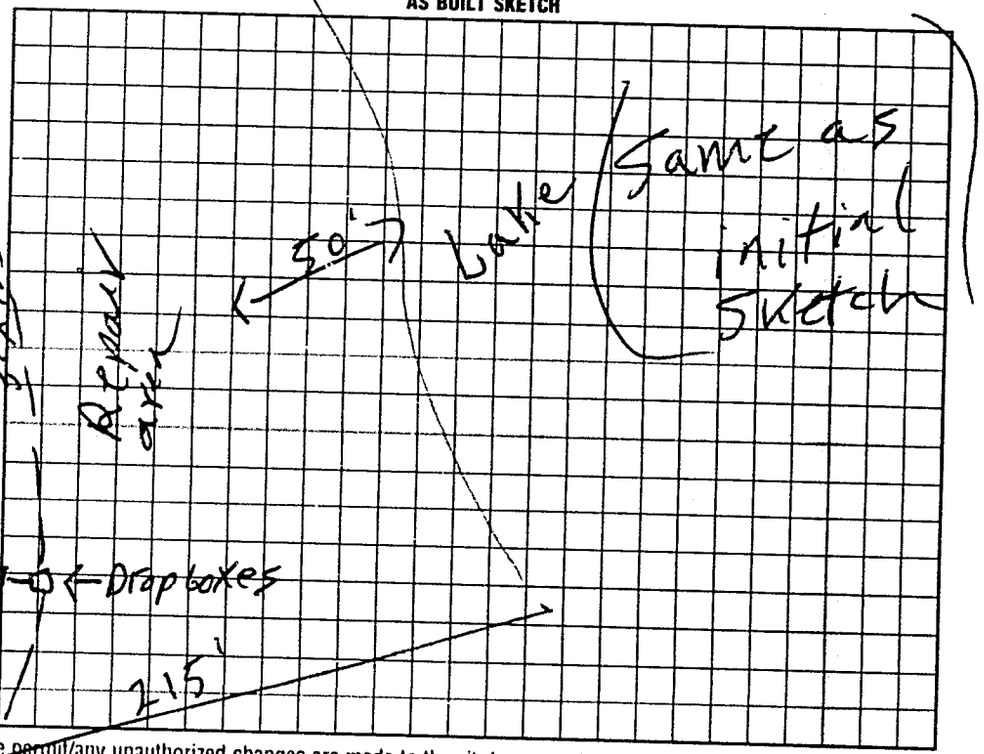

I understand that this permit can be suspended or revoked if any false information is supplied toward securing the permit/any unauthorized changes are made to the site/any unauthorized changes are made in the installation of the system. Improvement Permit with plat valid without expiration. Improvement Permit with site plan valid for sixty months. Authorization to Construct is valid for a period equal to that of Improvement Permit – not to exceed sixty months.

Signed: X Brian K. Souther date 4/30/98 Installed by: Duvit Yountz

Improvement Permit by: R. C. Moore date 4-30-98 Operation Permit by: R. C. Moore date 11-12-98

Authorization to Construct by: R. C. Moore date 4-30-98 Existing System Inspection by: date

HEALTH DEPT COPY WHITE INSPECTION COPY (FINAL) GREEN OWNER COPY (FINAL) YELLOW INSPECTION COPY (INITIAL) PINK OWNER COPY (INITIAL) GOLD