IREDELL COUNTY HEALTH DEPARTMENT

STATESVILLE 704-878-5305 MOORESVILLE 704-664-5281

IMPROVEMENT PERMIT / AUTHORIZATION TO CONSTRUCT / OPERATION PERMIT / EXISTING SYSTEM INSPECTION

PERMIT# REPAIR PIN# 4736-52-2287 DATE 5-6-02

OWNER OR CONTRACTOR KATHY ESTES PHONE: Business Home 704-873-8320

ADDRESS 157 TWIN LAKES DRIVE, STATESVILLE, NC 28625

LOCATION NC 115 N TR S. CATHEY FORD, TR TWIN LAKES DR LOT ON LEFT AT #157

SUBDIVISION FORT DOBBS FARMS / SECTION LOT 41 LOT AREA AMPLE SITE CLASS PS DESIGN FLOW 360 GPD L.T.A.R. 0.30 GPD/FT²

Septic Tank EXISTING Gallons: STB Date

Pump Tank: Gallons: PT Date

Pump Make: Model Serial No

Nitrification Field: No Fields 1 Square Feet EQ TO 600 Linear Feet 150'

No Lines TWO Trench Width 36" Max Trench Bottom Depth 36" Gravel Depth N/A

☐ New System ☑ Repair System Type: I, II, III, IV, V

System Description: 25% REDUCTION, GRAVITY

Repair System Description: 25% REDUCTION, GRAVITY

Maintenance Agreement Required: ☐ Yes ☑ No

☑ House/Mod. Home No. Bedrooms 3

☐ Mobile Home No. Bathrooms 3½

☐ Business No. Employees

☐ Other


☐ Slab ☐ Crawl Space ☑ Basement w/plumbing ☐ Basement wo/plumbing

Water Supply: ☐ Individual ☑ Public ☐ Community


Comments/Conditions: ① INSTALL 25% REDUCTION SYSTEM IN TWO LINES AS SHOWN ② THIS PERMIT SERVES AS "NOTICE OF VIOLATION", SYSTEM TO BE REPAIRED BY 6-6-02

Comments/Conditions:

INITIAL SITE SKETCH

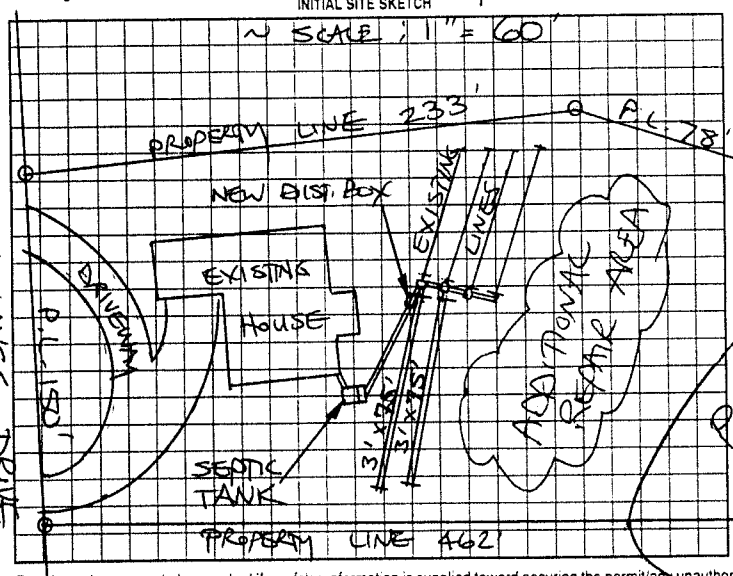

AS BUILT SKETCH

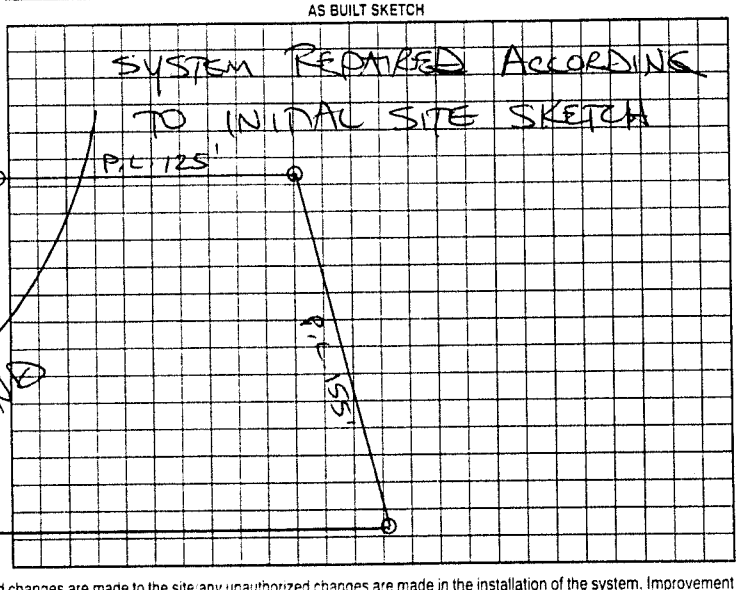

Permit can be suspended or revoked if any false information is supplied toward securing the permit/any unauthorized changes are made to the site any unauthorized changes are made in the installation of the system. Improvement Permit with plat valid without expiration. Improvement Permit with site plan valid for sixty months. Authorization to Construct is valid for a period equal to that of Improvement Permit - not to exceed sixty months.

Signed: Kathy Estes date 5-6-02 Installed by: JAMES HUDLER

Improvement Permit by: STEVE HEDRICK date 5-6-02 Operation Permit by: STEVE HEDRICK date 5-17-02

Authorization to Construct by: STEVE HEDRICK date 5-6-02 Existing System Inspection by: date

HEALTH DEPT. COPY: WHITE OWNER COPY (FINAL): YELLOW OWNER COPY (INITIAL): PINK