IREDELL COUNTY HEALTH DEPARTMENT

STATESVILLE 704-878-5305 MOORESVILLE 704-664-5281

IMPROVEMENT PERMIT / CERTIFICATE OF COMPLETION / OPERATION PERMIT / EXISTING SYSTEM INSPECTION

PROPERTY DESCRIPTION NO. 19546 DATE 8-2-96 TAX MAP NO. 10D- A-20 Watershed: ☐ Yes ☐ No

OWNER OR CONTRACTOR Cyrl B. Outen PHONE Business 664-8054 Home 872-5486

ADDRESS 306 Brookfield Dr. Statesville

LOCATION S. Chipley Ford TR Twin Lakes Rd. before entering RS.

SUBDIVISION Ft. Dobbs Fm BLOCK / SECTION LOT 35 LOT AREA 2.3 acres SITE CLASS. P5 DESIGN FLOW 360 L.T.A.R. .3

Septic Tank: 1000 Gallons; STB 1007 Date 6-11-97
Pump Tank: Gallons; PT Date
Pump Make: Model Serial No.
Nitrification Field: No Fields 1 Square Feet 900 Linear Feet 300
No Lines 4 Trench Width 36" Max Trench Bottom Depth 36" Gravel Depth N/A

☐ New System ☐ Repair System Type: I, II, III, IV, V, VI
System Description: Gravity Chambers
Repair System Description: " "
Maintenance Agreement Required: ☐ Yes ☐ No

☐ Mo. se/Mod. Home ☐ Mobile Home ☐ Business ☐ Other
No. Bedrooms 3 No. Bathrooms 2 No. Employees


☐ Slab ☐ Crawl Space ☐ Basement w/plumbing ☐ Basement w/o plumbing

Water Supply:
☐ Individual
☐ Community
☐ Public


Comments: Replaces Permit Issued 11-16-94

Comments:

INITIAL SITE SKETCH

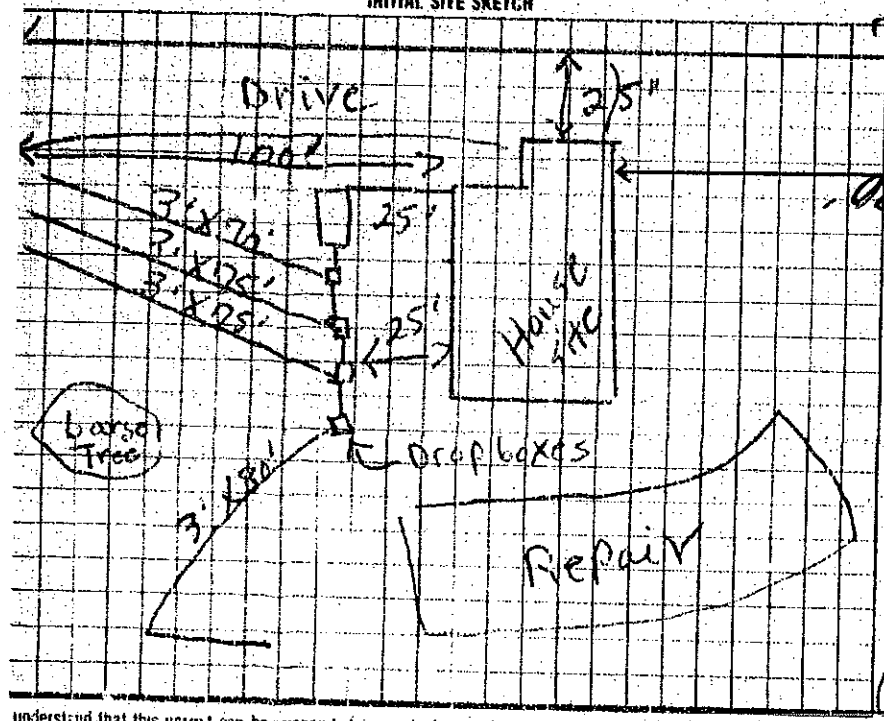

AS BUILT SKETCH

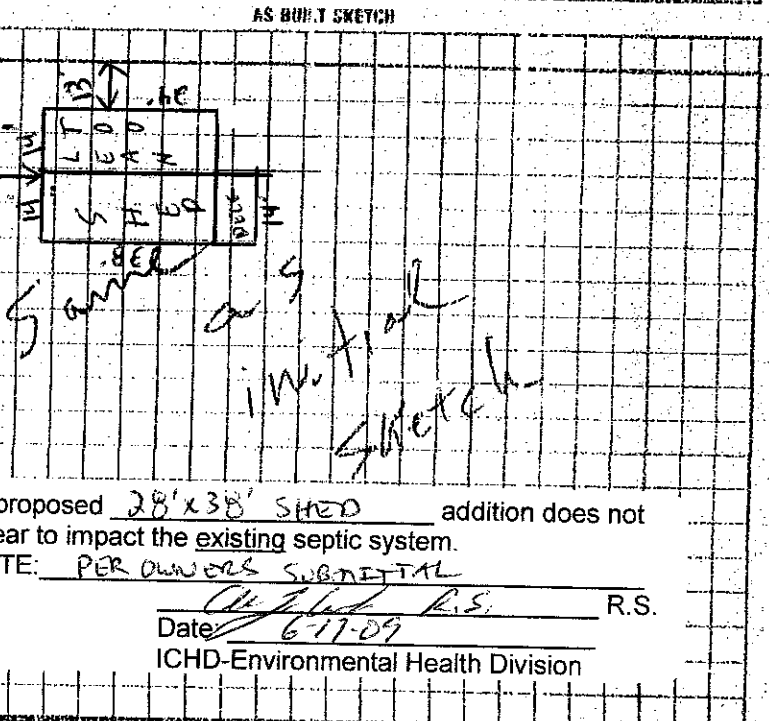

The proposed 28'x38' SHED addition does not appear to impact the existing septic system.

**NOTE: PER OWNERS SUBMITTAL

R.S.

Date 6-11-09

ICHD-Environmental Health Division

I understand that this permit can be suspended or revoked if any false information is supplied toward securing the permit/any unauthorized changes are made to the site/any unauthorized changes are made in the installation of the system.

Signed: Rita J. Outen

Improvement Permit by: L.C. Moore date 8-2-96

Certificate of Completion by: L.C. Moore date 8-2-96

Installed by: Kenny Pearson

Operation Permit by: L.C. Moore date 7-2-97

CONTRACTOR COPY (FINAL): WHITE INSPECTION COPY (FINAL): GREEN OWNER COPY (FINAL): YELLOW INSPECTION COPY (INITIAL): PINK

Authorization to cover expires 60 mos. from issue

JAN. 8, 1989 17:27