IREDELL COUNTY HEALTH DEPARTMENT

STATESVILLE 704-878-5305 MOORESVILLE 704-664-5281

IMPROVEMENT PERMIT / CERTIFICATE OF COMPLETION / OPERATION PERMIT / EXISTING SYSTEM INSPECTION

62097

PROPERTY DESCRIPTION NO. 20823 DATE 5-18-95 TAX MAP NO. 10D-2-A-38 Watershed: ☐ Yes ☑ No

OWNER OR CONTRACTOR Frank Childress PHONE: Business Home 873-9437

ADDRESS 104 Wickersham Dr Statesville

LOCATION N.C. 115 TR Chipley Ford Rd TR Twin Lakes Dr. at end

SUBDIVISION Ft Dobbs Farm BLOCK / SECTION LOT 38 LOT AREA 8.0 acres SITE CLASS. PS DESIGN FLOW 360 L.T.A.R. .75

Septic Tank: 1000 Gallons; STB 1194 Date 8-29-96

Pump Tank: Gallons; PT Date

Pump Make: Model Serial No.

Nitrification Field: No Fields Square Feet 1080 Linear Feet 360

No Lines 4 Trench Width 36" Max Trench Bottom Depth 36" Gravel Depth 12"

☑ New System ☐ Repair System Type: I, II, III, IV, V, VI

System Description: Conv. Gravity

Repair System Description: " "

Maintenance Agreement Required: ☐ Yes ☑ No

☑ House/Mod. Home No. Bedrooms 3

☐ Mobile Home No. Bathrooms 2½

☐ Business No. Employees

☑ Other


☐ Slab ☐ Crawl Space ☑ Basement w/plumbing ☐ Basement wo/plumbing

Water Supply: ☐ Individual ☐ Community ☑ Public


Comments:

Comments:

INITIAL SITE SKETCH

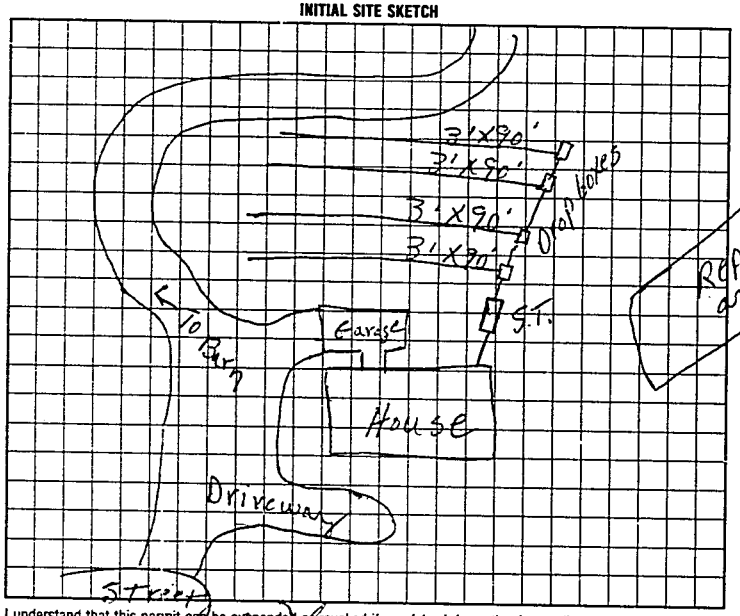

AS BUILT SKETCH

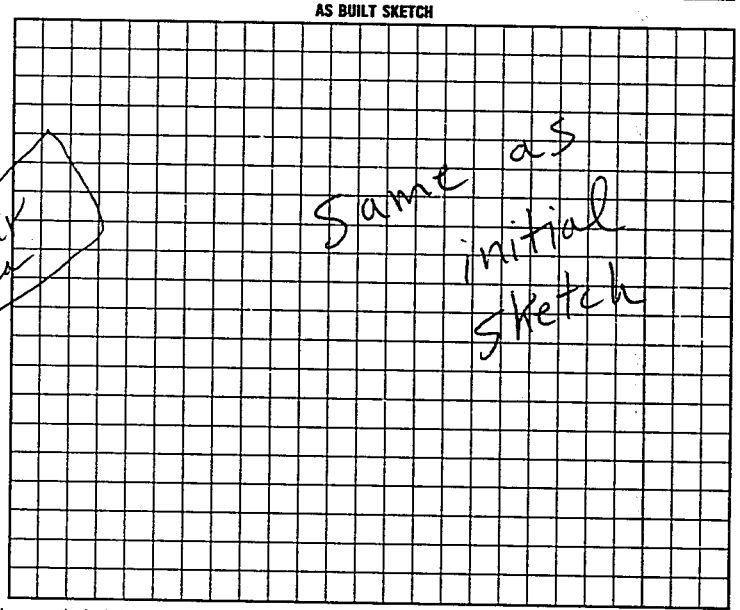

I understand that this permit can be suspended or revoked if any false information is supplied toward securing the permit/any unauthorized changes are made to the site/any unauthorized changes are made in the installation of the system. Improvement Permit is valid for 60 months from date of issuance.

Signed: X

Improvement Permit by: R. C. Moore date 5-18-95

Existing System Inspection by: date

Installed by: James Hutler

Certificate of Completion by: date

Operation Permit by: R. C. Moore date 10-1-96

HEALTH DEPT COPY: WHITE INSPECTION COPY (FINAL): GREEN OWNER COPY (FINAL): YELLOW INSPECTION COPY (INITIAL): PINK OWNER COPY (INITIAL): GOLD

L 8 8 2 0 0