IREDELL COUNTY HEALTH DEPARTMENT

STATESVILLE 704-878-5305 MOORESVILLE 704-664-5281

IMPROVEMENT PERMIT / AUTHORIZATION TO CONSTRUCT / OPERATION PERMIT / EXISTING SYSTEM INSPECTION

PERMIT# Repair PIN# 4736-54-6377 DATE 7/1/04

OWNER OR CONTRACTOR Ronald Cash PHONE: Business Home (704) 876-0890

ADDRESS 316 Clearview Rd Statesville, N.C. 28625

LOCATION Hwy 21 N, (L) Fort Dobbs Rd, (R) on Chipley Ford Rd, (R) on Clearview Road @ 316 Clearview Road

SUBDIVISION BLOCK / SECTION LOT LOT AREA SITE CLASS. 5 DESIGN FLOW 360 L.T.A.R. .4

Septic Tank: Existing Gallons; STB Date

Pump Tank: Gallons; PT Date

Pump Make: Model Serial No.

Nitrification Field: No Fields 1 Square Feet Eq to @ 825 Linear Feet 226

No Lines 5 @ 44' Trench Width 36" Max Trench Bottom Depth NA Gravel Depth NA

☐ New System ☒ Repair System Type: I, II, (III) IV, V, VI

System Description:

Repair System Description: Gravity, 25% Red

Maintenance Agreement Required: ☐ Yes ☐ No

☒ House/Mod. Home No. Bedrooms 3

☐ Mobile Home No. Bathrooms 1½

☐ Business No. Employees

☐ Other


☐ Slab ☒ Crawl Space ☐ Basement w/plumbing ☐ Basement wo/plumbing

Water Supply: ☒ Individual ☐ Public ☐ Community Well

Comments/Conditions: (1) Pump out Septic Tank (2) Check Dist. box (Replace if Needed) (3) Check Pit Area (4) TREE (maple) must be removed before Adding New Lines if Needed after Observing Conditions (1-3), (5) New Lines if Needed (6) Use this permit same as N.O.C. - Maple tree removed, dist box removed. - Installed 35 Infiltrator Chambers as shown - Replaced tee in Septic Tank.

INITIAL SITE SKETCH

Add 5 Lines 44' off of 25% Reduction System

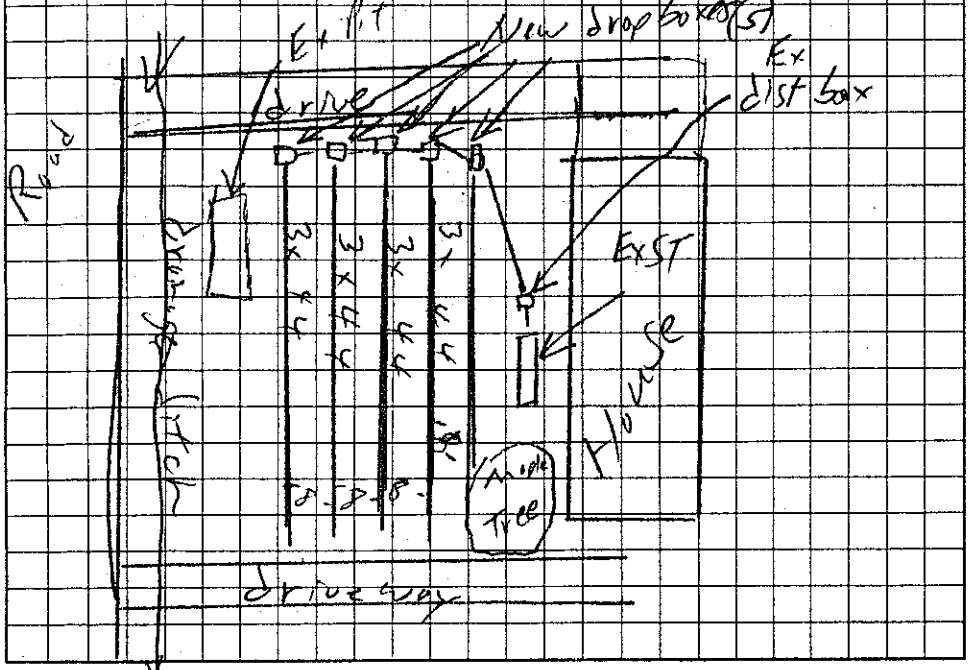


AS BUILT SKETCH

Ex Pit below (4) New lines.

- Must Repair leaking Faucets in House

Installed As Shown

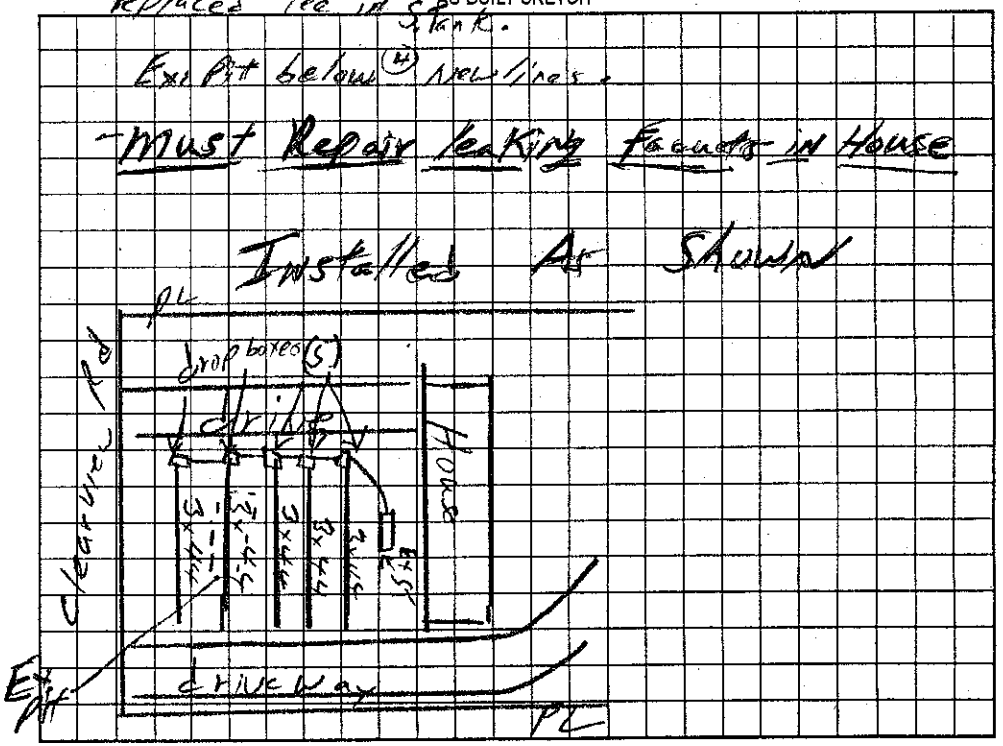

Permit can be suspended or revoked if any false information is supplied toward securing the permit/any unauthorized changes are made to the site/any unauthorized changes are made in the installation of the system. Improvement Permit with plat valid without expiration. Improvement Permit with site plan valid for sixty months. Authorization to Construct is valid for a period equal to that of Improvement Permit – not to exceed sixty months.

Signed: Ronald Cash date

Improvement Permit by: William O. Johnson date 7/1/04

Authorization to Construct by: William O. John date 7/1/04

Installed by: Steve Jordan

Operation Permit by: William O. Johnson date 7/2/04

Existing System Inspection by: date

HEALTH DEPT. COPY: WHITE OWNER COPY (FINAL): YELLOW OWNER COPY (INITIAL): PINK