IREDELL COUNTY HEALTH DEPARTMENT

Statesville Phone TR 3-7271 Mooresville Phone NO 3-1271

PERMIT TO INSTALL SEPTIC TANK

Permit No. Benge 106 Permit Date June 24 1969

Owner Carl Buck Elder. Address City

Installed By Hoke & Sons Address R 7


Location of Property Lackey Rd. off Chip Ford Rd take C. Ford Rd. cross 2 creeks Right 1st hard top - on left 1/4 mile Clear View S/D

Tank		Capacity		Length of Lines		Fixtures	
Block	( )	1000	( )	225'	( )	No. of Baths	(2)
Precast	(2)	1250	( )	250'	( )	Dishwasher	( )
wash		1500	( )	Other		Garbage Grdr.	( )
		Other				Other	

NOTIFY HEALTH DEPARTMENT AT LEAST EIGHT HOURS BEFORE TANK IS TO BE INSPECTED.

Final Inspection 19 Approved ( ) Disapproved ( )

Remarks well 75' Tight soil - Not liable harm from grade changes or landscape work

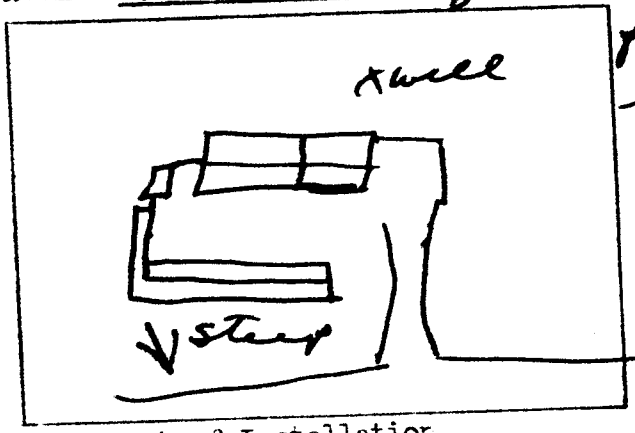

Sketch of Installation

Sanitarian