IREDELL COUNTY HEALTH DEPARTMENT

STATESVILLE 704-878-5305 MOORESVILLE 704-664-5281

IMPROVEMENT PERMIT / AUTHORIZATION TO CONSTRUCT / OPERATION PERMIT / EXISTING SYSTEM INSPECTION

PERMIT# Repair PIN# DATE 2-22-99

OWNER OR CONTRACTOR James Henderson PHONE: Business Home 876-3886

ADDRESS 2395 S. Chipley Ford Statesville

LOCATION S Chipley Ford Rd Cross 4th Creek 3rd House on L

SUBDIVISION BLOCK / SECTION LOT LOT AREA SITE CLASS DESIGN FLOW 240 L.T.A.R. Existing

Septic Tank: 1000 Gallons; STB Date

Pump Tank: Existing Gallons; PT Date

Pump Make: Model Serial No.

Nitrification Field: No Fields Square Feet Linear Feet

No Lines Trench Width 6ft Max Trench Bottom Depth 36in Gravel Depth 24in

☐ New System ☒ Repair System Type: I. II. III. IV. V. VI

System Description:

Repair System Description: Gravity Convn. Bed

Maintenance Agreement Required: ☐ Yes ☒ No

☒ House/Mod. Home No. Bedrooms 2

☐ Mobile Home No. Bathrooms 1

☐ Business No. Employees

☐ Other

☐ Slab ☒ Crawl Space ☐ Basement w/plumbing ☐ Basement wo/plumbing

Water Supply: ☐ Individual ☒ Public ☐ Community well on site


Comments/Conditions:

Replace 20-30ft old system.
If old system once exposed is Not ~~useable~~ useable - will need to add New lines


Comments/Conditions

* Replaced old pipe between Dist Box and Bed system

INITIAL SITE SKETCH

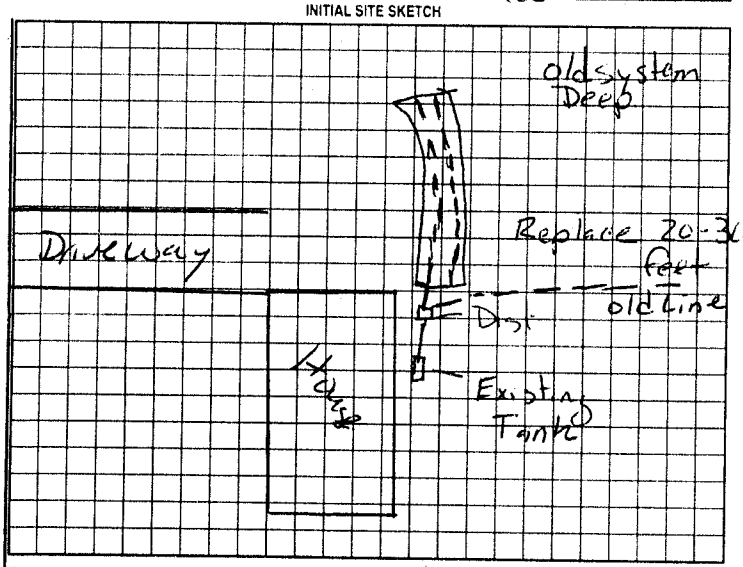

AS BUILT SKETCH

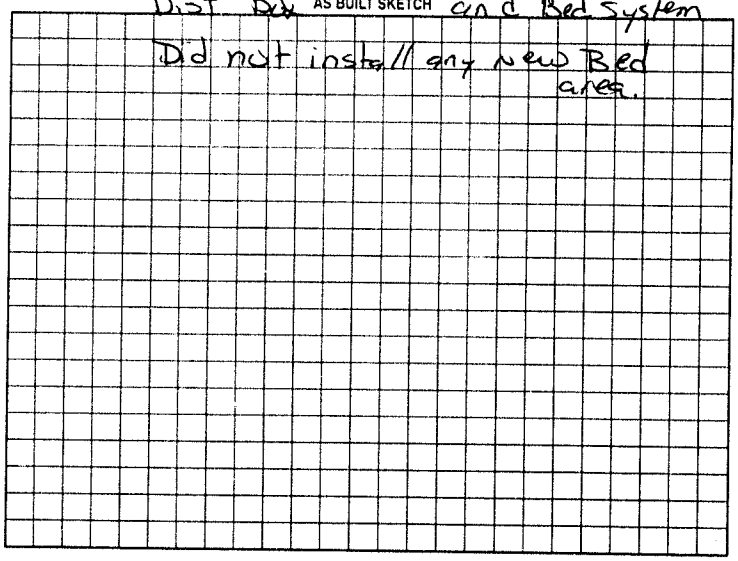

Permit can be suspended or revoked if any false information is supplied toward securing the permit/any unauthorized changes are made to the site/any unauthorized changes are made in the installation of the system. Improvement Permit with plat valid without expiration. Improvement Permit with site plan valid for sixty months. Authorization to Construct is valid for a period equal to that of Improvement Permit - not to exceed sixty months.

Signed: Janet K Pfingsmeier date

Improvement Permit by: Mary C Ott RS date 2-22-99

Authorization to Construct by: Mary C Ott RS date 2-22-99

Installed by:

Operation Permit by: Mary C Ott date 2-23-99

Existing System Inspection by: date

(HEALTH DEPT. COPY. WHITE) OWNER COPY (FINAL) YELLOW OWNER COPY (INITIAL) PINK