IREDELL COUNTY HEALTH DEPARTMENT

Statesville Office (704) 878-5305 Mooresville Office (704) 660-3625 PERMIT # 178143

IMPROVEMENT PERMIT / AUTHORIZATION TO CONSTRUCT / OPERATION PERMIT / EXISTING SYSTEM

PIN # 4736551059

APPLICANT: Michael Bicio APPLICANT ADDRESS: 2395 S. Chipley Ford Rd.

SITE ADDRESS: 2395 S. Chipley Ford Rd PHONE: 704-380-1510 ALT. PHONE: N/A

SITE DIRECTIONS: Hwy 115 N TR S. Chipley Ford Rd. 2nd house on Left after Clearview Rd.

SUBDIVISION: N/A SECTION: N/A LOT # N/A LOT AREA: 1.52 acres DESIGN FLOW: 360gpd L.T.A.R.: 0.3

Septic Tank Existing (gal) STB Date
Pump Tank (gal) PT Date
Pump Make Model Serial #
Nitrification Fields 1 # Lines 1 Linear Ft: 100
Trench Width 36" Max. Trench Bottom Depth 36" Gravel Depth N/A


☐ New System ☐ Repair ☑ Expansion System Type: I II (III) IV V VI
System Description: 25% Reduction
Repair System Description: 25% Reduction
Maintenance Agreement Required: ☐ YES ☑ NO
☑ GRAVITY ☐ PRESSURE

☑ Residence No. Bedrooms 3
☐ Business No. Persons
☐ Other No. Employees
☐ Slab ☑ Crawl Space
☐ Basement w/plumbing ☐ Basement w/o plumbing

Water Supply: ☐ Private ☑ Public ☐ Community

Comments / Conditions: Install 100' of a 25% Reduction system on contour. Connect to existing drainfield using effluent splitter such as Zoeller. Send 2/3 of effluent to existing drainfield & send 1/3 of effluent to new drainline. Replace septic tank if needed.

INITIAL SITE SKETCH

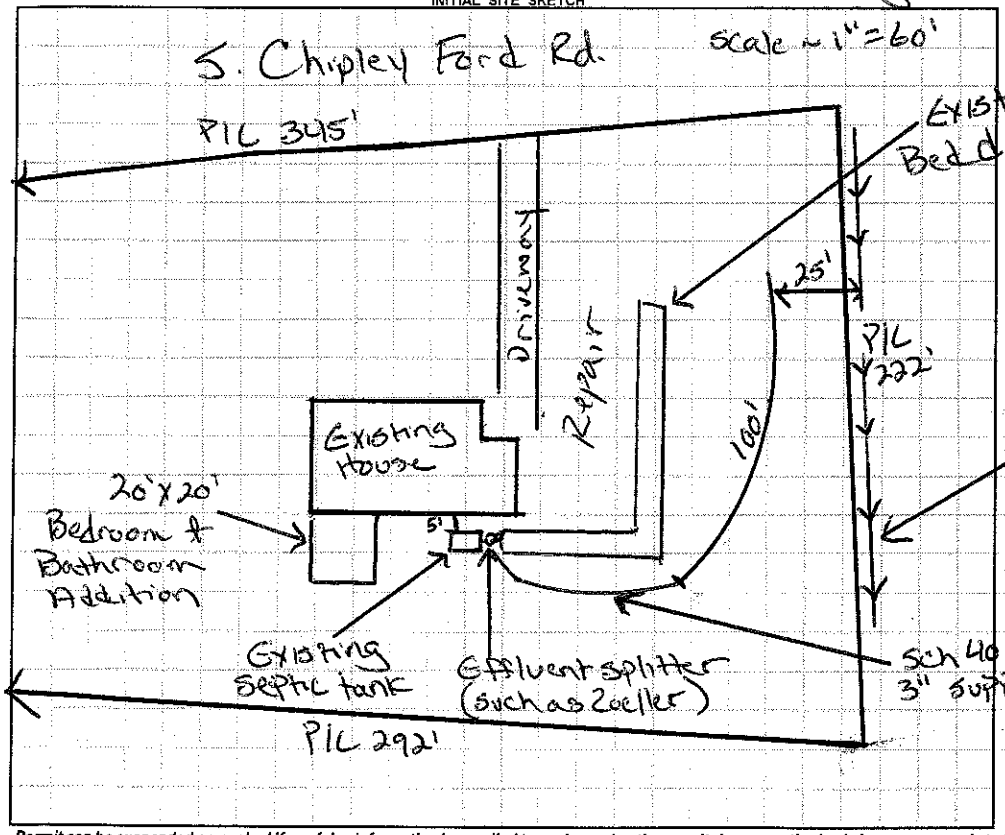

AS BUILT SKETCH

- Quick 4 Chambers installed

Permit can be suspended or revoked if any false information is supplied toward securing the permit / any unauthorized changes are made to the site / any unauthorized changes are made in the installation of the system. **CONTACT A LOCATOR SERVICE PRIOR TO ANY EXCAVATION**

☐ **IMPROVEMENT PERMIT** *with plat valid without expiration.* ☑ **IMPROVEMENT PERMIT** *with site plan valid for 60 mos.* ☑ **AUTHORIZATION TO CONSTRUCT** *valid for period equal to IMPROVEMENT PERMIT--not to exceed 60 mo.*

Owner / Applicant Signature: MKBicio Date: 8-21-13 Installed by: A1 - Backhoe

IMPROVEMENT PERMIT by: Justin Henderson Date: 8-20-13 OPERATION PERMIT by: Justin Henderson Date: 10-14-13

AUTHORIZATION TO CONSTRUCT by: Justin Henderson Date: 8-20-13 Existing System Inspected by: Date:

Health Dept. Copy - WHITE Applicant (Final Approval) - YELLOW Applicant (Conditional Approval) - PINK