IREDELL COUNTY HEALTH DEPARTMENT

STATESVILLE 704-878-5305 MOORESVILLE 704-664-5281

IMPROVEMENT PERMIT / AUTHORIZATION TO CONSTRUCT / OPERATION PERMIT / EXISTING SYSTEM INSPECTION

PERMIT# _____ PIN# _____

OWNER OR CONTRACTOR Luther Webster DATE 6-16-98

ADDRESS 154 Crosswhite Ln PHONE: Business _____ Home 876 1484

LOCATION 115 N TR Chipley Fork Cross 4th crossroads TL Crosswhite 1/4 mi Rt Statesville

SUBDIVISION Chipley Pk. BLOCK / SECTION _____ LOT _____ LOT AREA 1/2 acre SITE CLASS. PS DESIGN FLOW 360 L.T.A.R. .35

Septic Tank: Ex. Gallons; STB _____ Date _____

Pump Tank: _____ Gallons; PT _____ Date _____

Pump Make: _____ Model _____ Serial No. _____

Nitrification Field: No Fields 1 Square Feet 375 Linear Feet 125

No Lines 2 Trench Width 36" Max Trench Bottom Depth 36" Gravel Depth 18"

☐ New System ☑ Repair System Type: I, II, III, IV, V, VI

System Description: _____

Repair System Description: Conv. Gravity

Maintenance Agreement Required: ☐ Yes ☑ No

☑ House/Mod. Home No. Bedrooms 3

☐ Mobile Home No. Bathrooms 2

☐ Business No. Employees _____

☐ Other _____


☐ Slab ☐ Crawl Space ☐ Basement w/plumbing ☐ Basement wo/plumbing

Water Supply: ☐ Individual ☑ Public ☐ Community

Comments:/Conditions:

Comments:/Conditions:

INITIAL SITE SKETCH

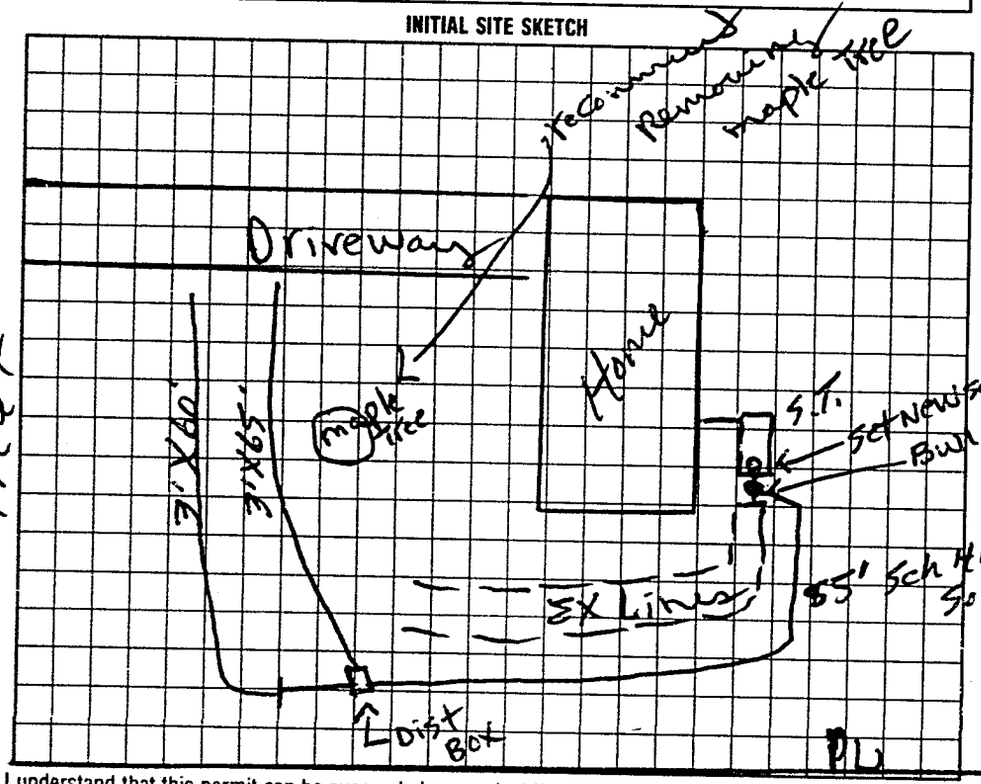

AS BUILT SKETCH

Installed as shown

I understand that this permit can be suspended or revoked if any false information is supplied toward securing the permit/any unauthorized changes are made to the site/any unauthorized changes are made in the installation of the system. Improvement Permit with plat valid without expiration. Improvement Permit with site plan valid for sixty months. Authorization to Construct is valid for a period equal to that of Improvement Permit – not to exceed sixty months.

Signed: X Luther Webster date _____

Improvement Permit by: P. C. Moore date 6-16-98

Authorization to Construct by: P. C. Moore date 6-16-98

Installed by: James Hudson

Operation Permit by: Mark Croft RS date 6-23-98

Existing System Inspection by _____ date _____

HEALTH DEPT COPY: WHITE INSPECTION COPY (FINAL): GREEN OWNER COPY (FINAL): YELLOW INSPECTION COPY (INITIAL): PINK OWNER COPY (INITIAL): GOLD