IREDELL COUNTY HEALTH DEPARTMENT

(SEPTIC TANK) IMPROVEMENTS PERMIT AND CERTIFICATE OF COMPLETION
(Ground Absorption Sewage Disposal System – G. S. Chapter 130-Article 13C)

OWNER OR CONTRACTOR Hope Bro. DATE 1-23-76 PERMIT NO.

PHONE: Business Home

LOCATION Chipley Park

S. R. No.


SUBDIVISION NAME Chipley Park LOT NO. 34 SECTION OR BLOCK NO.

House (✓) Mobile Home ( ) Business ( ) Other

No. Bedrooms 3 No. Bathrooms 2

Garbage Disposal Unit	Yes ( )	No (✓)	Character & Porosity of Soil	Cecil Clay
Auto. Dishwasher	Yes ( )	No (✓)	Percolation Rate	—
Auto. Wash. Machine	Yes (✓)	No ( )	Topography	Slope to back
Site Suitable	Yes (✓)	No ( )	Depth to Water Table	Low
			Rock or other impervious formations	None

Lot Area 20 000 Sq ft.

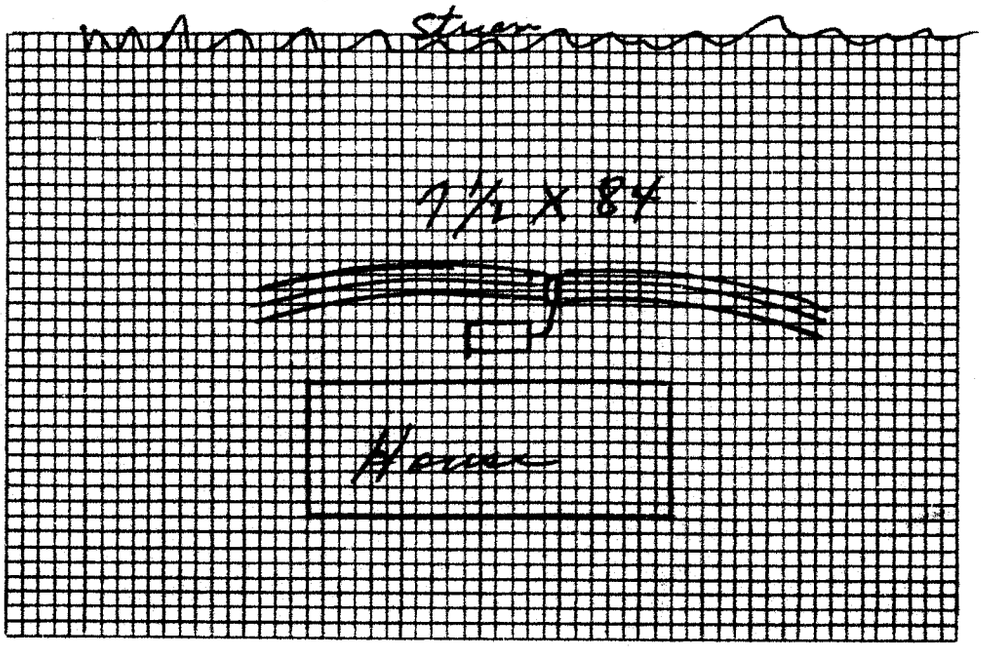

Plot of System

Size of Tank 1000 Gals.
Nitrification Field:
No. of Lines 3
Sq. Ft. 625 Linear Ft. 250
Depth of Stone in Lines 10"
Water Supply: Individual ( )
Public (✓)

Installed by Hope Bro

IMPROVEMENTS PERMIT BY

COMMENTS: Down spouts and surface water to be diverted away from tank and drain field. Stub out Not as laid out.

CERTIFICATE OF COMPLETION BY E. A. Stevenson DATE 1-23-76

CONSTRUCTION MUST COMPLY WITH ALL OTHER APPLICABLE STATE AND LOCAL REGULATIONS.

Health Dept. Copy: White Inspection Dept. Copy: Yellow Sanitarian's Copy: Pink Owner's Copy: Gold