IREDELL COUNTY HEALTH DEPARTMENT

Statesville Phone TR 3-7271 Mooresville Phone NO 3-1271

PERMIT TO INSTALL SEPTIC TANK

Permit NO. B Steadman Bldr. Permit Date July - 2 1968

Owner Charles Wiggins Address Colonial Acres.

Installed By E Hoke Address


Location of Property Lot #5 - Corner Margate Dr. and Faye St.

Tank		Capacity		Length of Lines		Fixtures	
Block	( )	800	( )	150'	( )	No. of Baths	(2)
Precast	(✓)	900	( )	175'	( )	Dishwasher	( )
		1000	(✓)	200'	( )	Garbage Grdr.	( )
		1100	( )	225'	(✓)	Auto-Washer	(✓)
		1200	( )	250'	( )	Other	
		Other		Other			

NOTIFY HEALTH DEPARTMENT AT LEAST EIGHT HOURS BEFORE TANK IS TO BE INSPECTED.

Final Inspection 7-2 1968 Approved (✓) Disapproved ( )

Remarks G.V.A. #100732

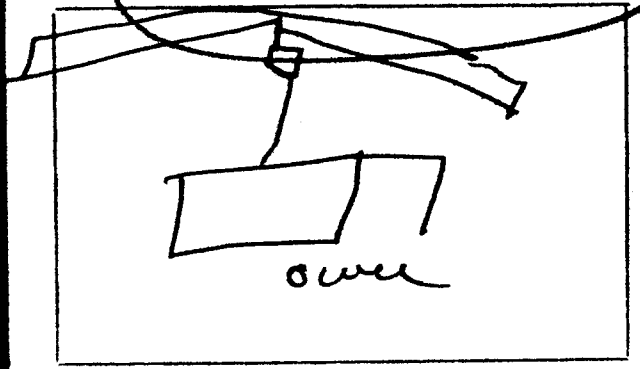

Sketch of Installation

Rut.

Sanitarian