IREDELL COUNTY HEALTH DEPARTMENT

Statesville Phone TR 3-7271 Mooresville Phone MO 3-1271

PERMIT TO INSTALL SEPTIC TANK

Permit NO. _____ Permit Date Aug 28 1963

Owner Steadman Building Co Address city

Installed By C Hoke Address _____


Location of Property Colony acres off Shipley Road Rd lot # 2

Tank		Capacity		Length of Lines		Fixtures	
Block	( )	800	( )	150'	( )	No. of Baths	(2)
Precast	(+)	900	( )	175'	( )	Dishwasher	( )
		1000	(+)	200'	( )	Garbage Grdr.	( )
		1100	( )	225'	(+)	Auto-Washer	(+)
		1200	( )	250'	( )	Other	_____
		Other	_____	Other	_____		

NOTIFY HEALTH DEPARTMENT AT LEAST EIGHT HOURS BEFORE TANK IS TO BE INSPECTED.

Final Inspection 9 28 1963 Approved (+) Disapproved ( )

Remarks well not down at this time (Not F.H.A.

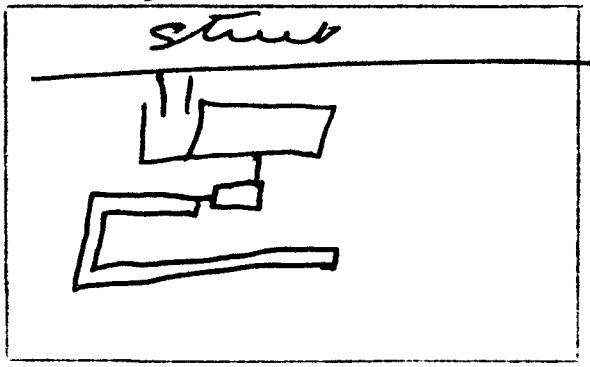

Sketch of Installation

Red.

Sanitarian