IREDELL COUNTY HEALTH DEPARTMENT

Statesville Phone TR 3-7271 Mooresville Phone NO 3-1271

PERMIT TO INSTALL SEPTIC TANK

Permit No. 48 Permit Date 8-8 1972

Owner Hope Bro Builders Address Statesville NC

Installed By Same Address


Location of Property Out Chipley Ford Road. Turn into Chipley Park on Road # 1943 House on L. Lot # 76

Tank		Capacity		Length of Lines		Fixtures	
Block	( )	1000	(✓)	225'	(✓)	No. of Baths	(1½)
Precast	(✓)	1250	( )	250'	( )	Dishwasher	( )
		1500	( )	Other		Garbage Grdr.	( )
		Other				Other	

NOTIFY HEALTH DEPARTMENT AT LEAST EIGHT HOURS BEFORE TANK IS TO BE INSPECTED.

Final Inspection 8-8 1972 Approved (✓) Disapproved ( )

Remarks Community Water

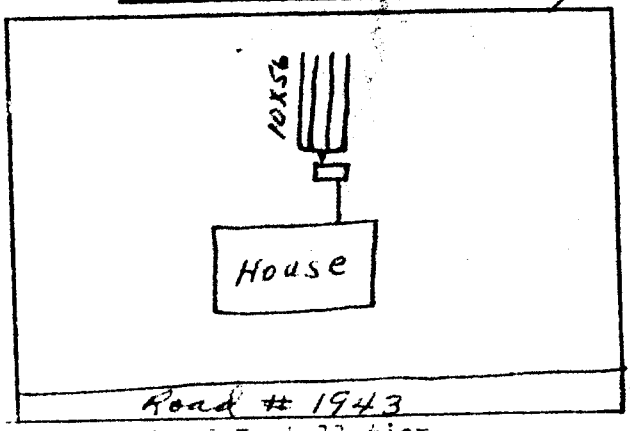

Sketch of Installation

E. A. Stevenson

Sanitarian