IREDELL COUNTY HEALTH DEPARTMENT

Statesville Phone TR 3-7271 Mooresville Phone No. 664-5281

PERMIT TO INSTALL SEPTIC TANK

Permit No. _____ Permit Date 28 Sept 1972

Owner Hope Brothers Blks Address Statesville, N.C.

Installed By Hope Brothers Address Statesville N.C.


Location of Property Chipley Park - Lot # 85

Tank		Capacity		Length of Lines		Pictures	
Block	( )	1000	(✓)	225'	( )	No. of Baths	1½
Precast	(✓)	1250	( )	250'	( )	Dishwasher	(—)
		1500	( )	Other 300		Garbage Grdr.	(—)
		Other				Other	

NOTIFY HEALTH DEPARTMENT AT LEAST EIGHT HOURS BEFORE TANK IS TO BE INSPECTED.

Final Inspection 28 Sept 1972 Approved (✓) Disapproved ( )

Remarks Community Water

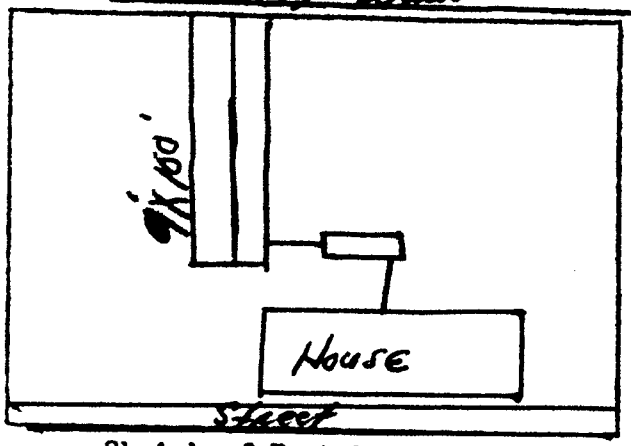

900 sq-ft.

Sketch of Installation

William A. Thrash

Sanitarian