IREDELL COUNTY HEALTH DEPARTMENT

Statesville Phone TR 3-7271 Mooresville Phone No. 664-5281

PERMIT TO INSTALL SEPTIC TANK

Permit No. 116 Permit Date 9-28 1973

Owner Hope Bros Builders Inc Address Statesville, NC

Installed By Hope Bros Address Statesville, NC


Location of Property Chipley Park
Lot #84

Tank		Capacity		Length of Lines		Fixtures	
Block	( )	1000	( )	225'	( )	No. of Baths	(1½)
Precast	(✓)	1250	( )	250'	( )	Dishwasher	( )
		1500	( )	Other 300		Garbage Grdr.	( )
		Other		900 sq ft		Other	

NOTIFY HEALTH DEPARTMENT AT LEAST EIGHT HOURS BEFORE TANK IS TO BE INSPECTED.

Final Inspection 9-28 1973 Approved (✓) Disapproved ( )

Remarks Community Water

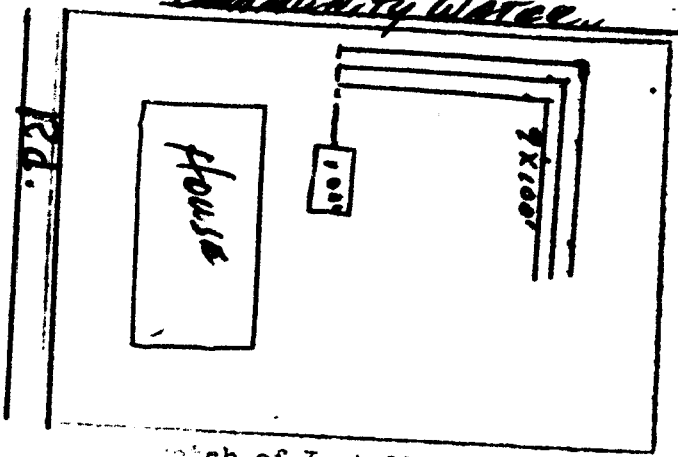

Sketch of Installation

Sanitarian