IREDELL COUNTY HEALTH DEPARTMENT

Statesville Phone TR 3-7271 Mooresville Phone NO 3-1271

PERMIT TO INSTALL SEPTIC TANK

Permit No. 174 Permit Date _____ 19__

Owner Hope Brothers Address _____

Installed By Hope Brothers Address _____


Location of Property Lot #74 Chipley Park

Tank		Capacity		Length of Lines		Fixtures	
Block	( )	1000	(✓)	225'	( )	No. of Baths	(1)
Precast	(✓)	1250	( )	250'	( )	Dishwasher	( )
		1500	( )	Other 290' 870 39'		Garbage Grdr.	( )
		Other _____				Other _____	

NOTIFY HEALTH DEPARTMENT AT LEAST EIGHT HOURS BEFORE TANK IS TO BE INSPECTED.

Final Inspection 4-4-78 Approved ✓ Disapproved ( )

Remarks Community Water. Meets county minimum requirements but not minimum F.H.A. + V.A. without perk tests.

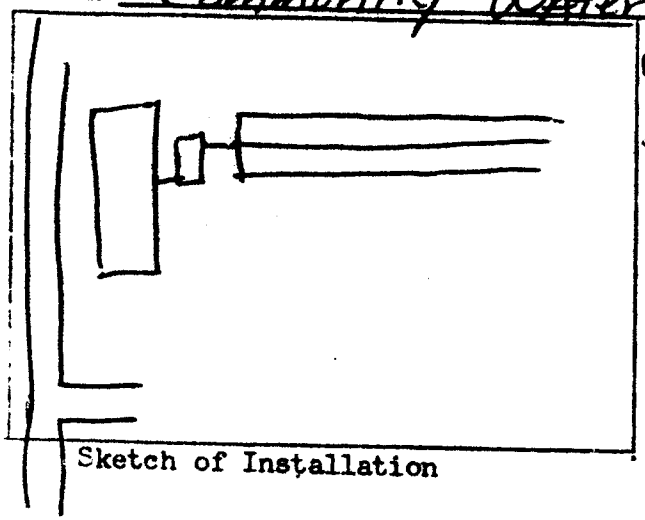

Sketch of Installation

Chas S. Hall

Sanitarian