IREDELL COUNTY HEALTH DEPARTMENT

Statesville Phone TR 3-7271 Mooresville Phone No. 664-528.

PERMIT TO INSTALL SEPTIC TANK

Permit No. 1[illegible] Permit Date 1-25 1973

Owner Hope Bro Builders Address Statesville NC

Installed By Hope Bro Address Statesville NC


Location of Property out Chipley Ford Rd to Chipley Park T.L. on Rd # 1943 Lot # 73

Tank		Capacity		Length of Lines		Fixtures	
Block	( )	1000	(✓)	225'	( )	No. of Baths	(1½)
Precast	(✓)	1250	( )	250'	( )	Dishwasher	(—)
		1500	( )	Other 300' 700 sq ft		Garbage Grdr.	(—)
		Other				Other	

NOTIFY HEALTH DEPARTMENT AT LEAST EIGHT HOURS BEFORE TANK IS TO BE INSPECTED.

Final Inspection 1-25 1973 Approved (✓) Disapprcved ( )

Remarks Community Water

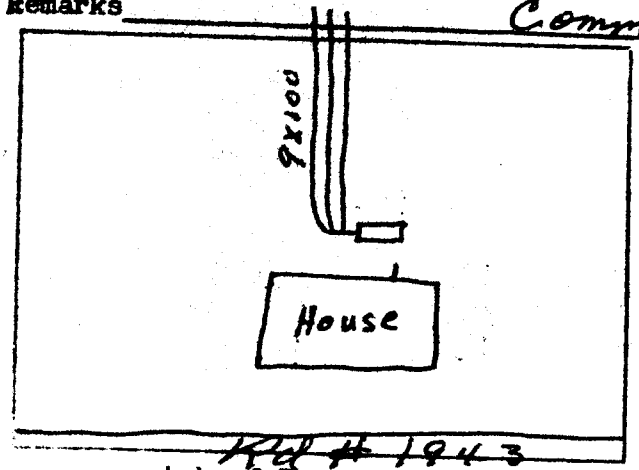

Sketch of Installation

E. G. Stevenson

Sanitarian