IREDELL COUNTY HEALTH DEPARTMENT

Statesville Phone TR 3-7271 Mooresville Phone No. 664-5281

PERMIT TO INSTALL SEPTIC TANK

Permit No. 2 Permit Date _____ 19__

Owner Hope Brothers Address _____

Installed By Hope Brothers Address _____


Location of Property Chipley Park Lot # 87

Tank		Capacity		Length of Lines		Fixtures	
Block	( )	1000	( )	225'	( )	No. of Baths	(4½)
Precast	(✓)	1250	( )	250'	( )	Dishwasher	( )
		1500	( )	Other 900 sq		Garbage Grdr.	( )
		Other _____				Other _____	

NOTIFY HEALTH DEPARTMENT AT LEAST EIGHT HOURS BEFORE TANK IS TO BE INSPECTED.

Final Inspection 5-10-1973 Approved (✓) Disapproved ( )

Remarks Community Water

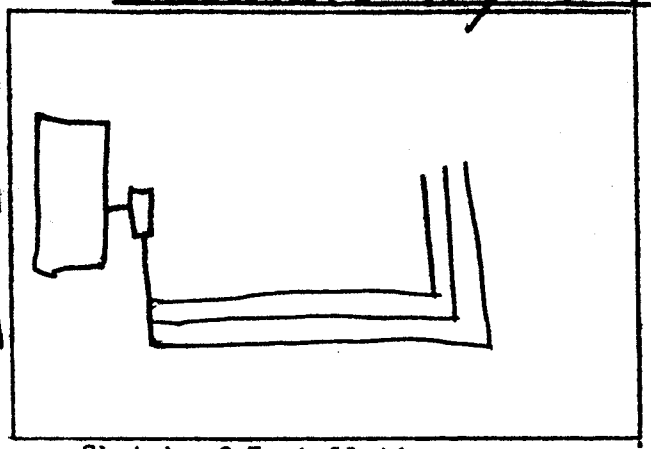

Sketch of Installation

C. S. Hall

Sanitarian