IREDELL COUNTY HEALTH DEPARTMENT

Statesville Phone TR 3-7271 Mooresville Phone No. 664-5281

PERMIT TO INSTALL SEPTIC TANK

Permit No. 7 Permit Date 10-18 1971

Owner Sue Davis Address Statesville N C

Installed By Harlen Lackey Address Stony Point N C


Location of Property Chipley Park.
Margaret Drive. 3rd House from end
of Stout. Lot 347-348-349-350

Tank		Capacity		Length of Lines		Fixtures	
Block	( )	1000	(✓)	225'	(✓)	No. of Baths	(1½)
Precast	(✓)	1250	( )	250'	( )	Dishwasher	( )
		1500	( )	Other		Garbage Grdr.	( )
		Other				Other	

NOTIFY HEALTH DEPARTMENT AT LEAST EIGHT HOURS BEFORE TANK IS TO BE INSPECTED.

Final Inspection 10-14 1971 Approved (✓) Disapprcved ( )

Remarks [redacted] Community Water

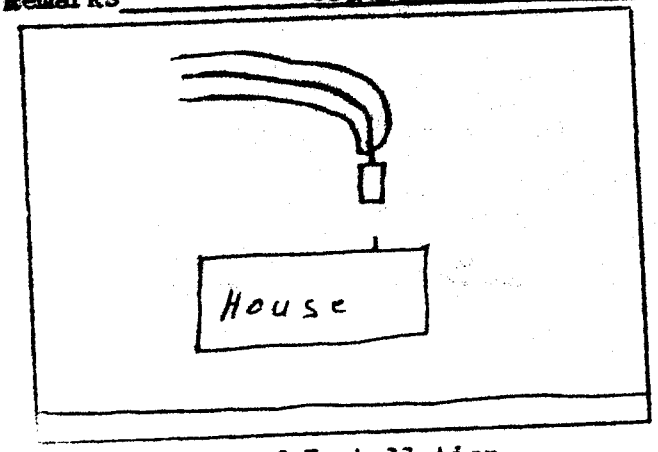

Sketch of Installation

E. G. Stevenson
Sanitarian