IREDELL COUNTY HEALTH DEPARTMENT

Statesville Phone TR 3-7271 Mooresville Phone No. 664-5281

PERMIT TO INSTALL SEPTIC TANK

Permit No. 21 Permit Date 10-25 1972

Owner Bldr. Hope Bros Builders Address

Installed By Hope Bros. + Hartness Address

Location of Property Chipley Park


Lot # 63

Tank		Capacity		Length of Lines		Fixtures	
Block	( )	1000	(✓)	225'	( )	No. of Baths	(1½
Precast	(✓)	1250	( )	250'	( )	Dishwasher	( )
		1500	( )	Other 300 900 sq ft		Garbage Grdr.	( )
		Other				Other	

NOTIFY HEALTH DEPARTMENT AT LEAST EIGHT HOURS BEFORE TANK IS TO BE INSPECTED.

Final Inspection 10-25 1972 Approved (✓) Disapprcved ( )

Remarks Community Water Supply

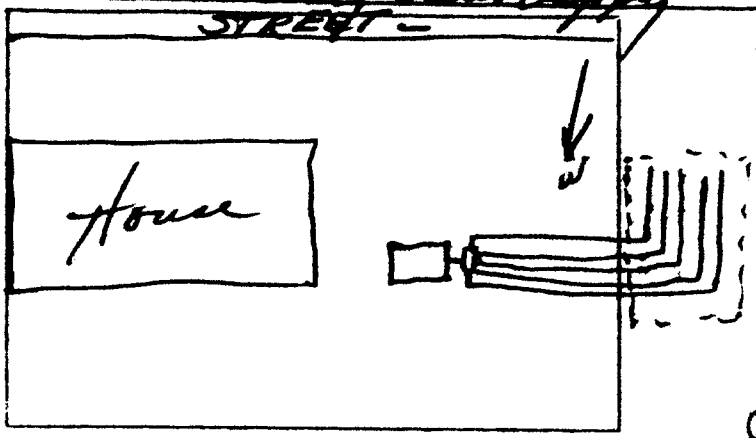

Sketch of Installation

This System installed by Hartness. was not called in and checked Hope Bros. recovered and added additional lines.

Sanitarian