IREDELL COUNTY HEALTH DEPARTMENT

Statesville Phone TR 3-7271 . Mooresville Phone No. 664-5281

PERMIT TO INSTALL SEPTIC TANK

Permit No. 771 Permit Date 10-12 1973

Owner Hope Bro Builders Address Statesville N.C.

Installed By Hope Bro Address


Location of Property Out Chipley Ford Rd to Chipley Park T.R. on Rd # 1943 Then T.R. on 1st Dirt Rd. House on L. Lot # 64

Tank		Capacity		Length of Lines		Fixtures	
Block	( )	1000	(✓)	225'	( )	No. of Baths	(1½)
Precast	(✓)	1250	( )	250'	( )	Dishwasher	(-)
		1500	( )	Other 300		Garbage Grdr.	(-)
		Other		900 sq ft		Other	

NOTIFY HEALTH DEPARTMENT AT LEAST EIGHT HOURS BEFORE TANK IS TO BE INSPECTED.

Final Inspection 10-12 1973 Approved (✓) Disapproved ( )

Remarks Community Water

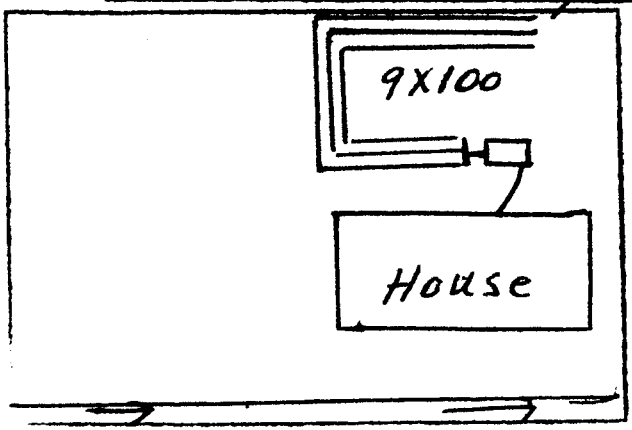

Sketch of Installation

E. G. Stevenson

Sanitarian