This permit voids permit issued 3-17-98

IREDELL COUNTY HEALTH DEPARTMENT

STATESVILLE 704-878-5305 MOORESVILLE 704-664-5281

IMPROVEMENT PERMIT / AUTHORIZATION TO CONSTRUCT / OPERATION PERMIT / EXISTING SYSTEM INSPECTION

PERMIT# Repair PIN# DATE 3-20-98

OWNER OR CONTRACTOR Rodney Goodman PHONE: Business 1-888-4170737 Home

ADDRESS 202 Roseman Ln Statesville

LOCATION 21N TL Shumaker TL Nixon TR Chrisley Ford TL Harriet TR Roseman last House on (R)

SUBDIVISION BLOCK / SECTION LOT LOT AREA SITE CLASS. DESIGN FLOW L.T.A.R.

Septic Tank: Existing Gallons; STB Date

Pump Tank: 1000 Gallons; PT 274 Date 12-10-97

Pump Make: Hydromatic Model SHEF33 Serial No.

Nitrification Field: No Fields 1 Square Feet Linear Feet 300

No Lines 4 Trench Width 36in Max Trench Bottom Depth 36in Gravel Depth ~~Sand~~

☐ New System ☒ Repair System Type: I (II) III IV, V, VI

System Description:

Repair System Description: Pump ~~Cover~~

Maintenance Agreement Required: ☐ Yes ☒ No

☒ House/Mod. Home No. Bedrooms 3

☐ Mobile Home No. Bathrooms 2

☐ Business No. Employees

☐ Other

☐ Slab ☒ Crawl Space ☐ Basement w/plumbing ☐ Basement wo/plumbing

Water Supply: ☒ Individual ☐ Public ☐ Community


Comments/Conditions: ① Install 4 lines 75ft chambers on contour 9ft on center ② keep pump tank supply line 50ft from well ③ Install subsurface Diversion Ditch - 10ft from system 48in Deep 6inches cover Bring to daylight

Comments/Conditions:


12 inches stone

4-2-98 Checked lines & manifold Box, Subsurface Drain

INITIAL SITE SKETCH

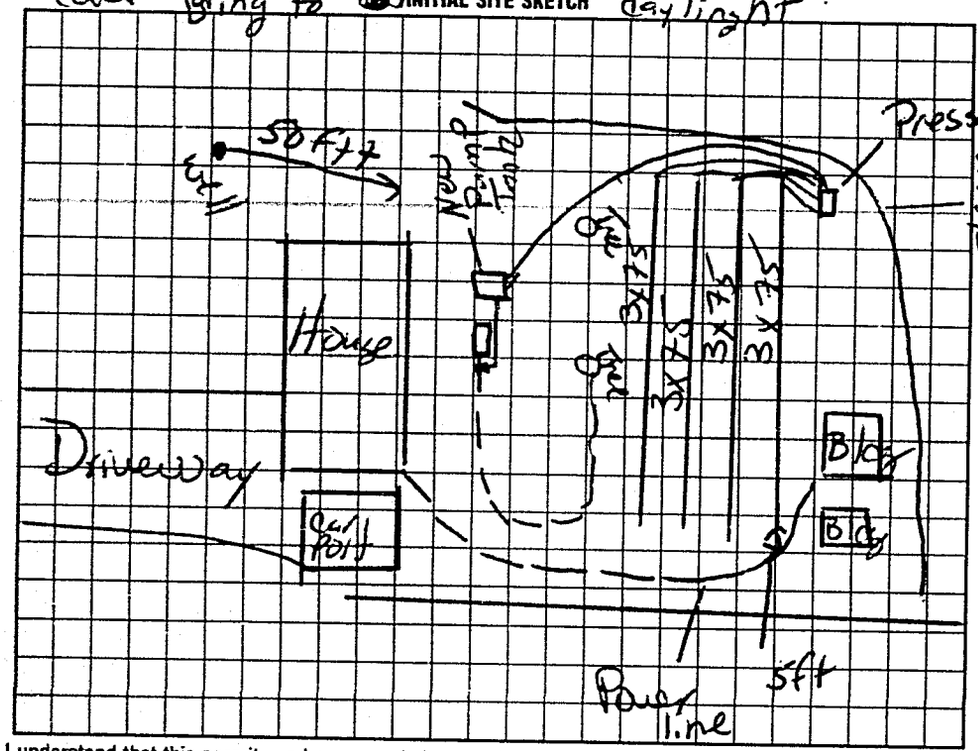

AS BUILT SKETCH

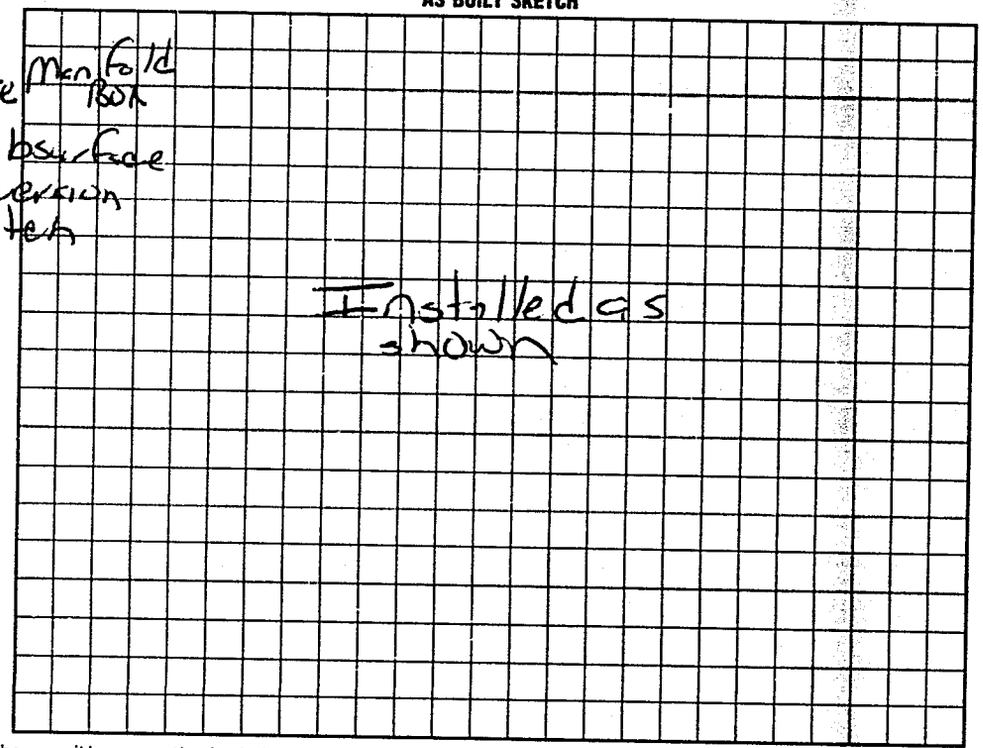

I understand that this permit can be suspended or revoked if any false information is supplied toward securing the permit/any unauthorized changes are made to the site/any unauthorized changes are made in the installation of the system. Improvement Permit with plat valid without expiration. Improvement Permit with site plan valid for sixty months. Authorization to Construct is valid for a period equal to that of Improvement Permit – not to exceed sixty months.

Signed: Rodney Goodman date

Improvement Permit by: Mary C Ortiz RS date 3-20-98

Authorization to Construct by: Mary C Ortiz RS date 3-20-98

Installed by: James Huddler

Operation Permit by: Mary C Ortiz RS date 4-13-98

Existing System Inspection by: date

HEALTH DEPT COPY WHITE INSPECTION COPY (FINAL) GREEN OWNER COPY (FINAL) YELLOW INSPECTION COPY (INITIAL) PINK OWNER COPY (INITIAL) GOLD