IREDELL COUNTY HEALTH DEPARTMENT

STATESVILLE 704-878-5305 CI MOORESVILLE 704-664-5281

CI

IMPROVEMENT PERMIT / AUTHORIZATION TO CONSTRUCT / OPERATION PERMIT / EXISTING SYSTEM INSPECTION

PERMIT# 119485 PIN# 4736-59-6235 DATE 4/29/04

OWNER OR CONTRACTOR Dennis Deal PHONE: Business (704) 872-5486 Home

ADDRESS 576 Snow Creek Rd Statesville N.C. 28625

LOCATION On Chipley Ford Rd, past Mtn Rd, On Harriet, On Rosemen Lane - 2nd lot on Right

SUBDIVISION Chipley Park BLOCK / SECTION - LOT 329-330 LOT AREA .459 Acre SITE CLASS. PS DESIGN FLOW 360 L.T.A.R. -30 gpd/sq ft

Septic Tank: 4000 Gallons; STB 1007 Date 2-27-04
Pump Tank: 1000 Gallons; PT 274 Date 4-20-04
Pump Make: Zoeller Model BN98-13 Serial No. —
Nitrification Field: No Fields 1 Square Feet Eq 6/200 Linear Feet 360
No Lines 4@75 Trench Width 36 Max Trench Bottom Depth 36" Gravel Depth N/A

☒ New System ☐ Repair System Type: I, II, III, IV, V, VI
System Description: Pump, 25% Reduction
Repair System Description: LP Panel
Maintenance Agreement Required: ☐ Yes ☒ No


☒ House/Mod. Home No. Bedrooms 3
☐ Mobile Home No. Bathrooms 2
☐ Business No. Employees
☐ Other
☐ Slab ☒ Crawl Space ☐ Basement w/plumbing ☐ Basement wo/plumbing

Water Supply: ☒ Individual ☒ Public ☐ Community
Private well

Comments:/Conditions: ① Attachments "A" & "B" are part of this permit

Comments:/Conditions:
- 48 Infi Hydy Chambers Installed Pressure check okay
- Zoller filter, ST marker + Riser Installed
- Electrical + Alarm Inspection Okay 11/4/04

INITIAL SITE SKETCH

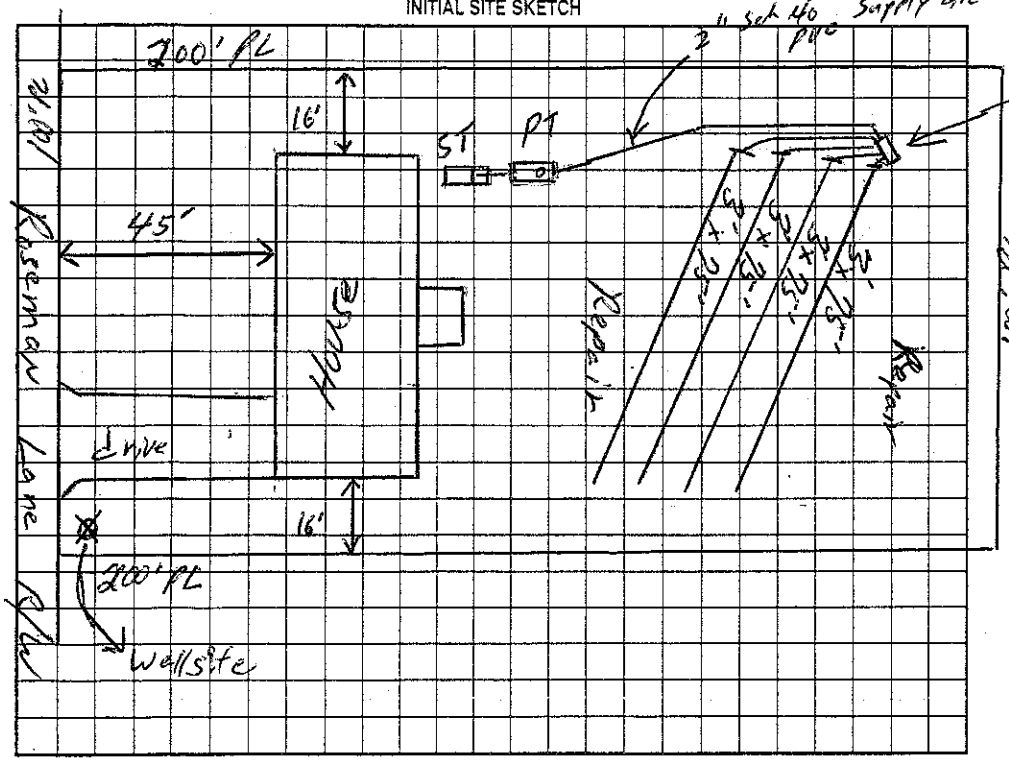

AS BUILT SKETCH

Installed As Shown Per Initial Site Sketch

Permit can be suspended or revoked if any false information is supplied toward securing the permit/any unauthorized changes are made to the site/any unauthorized changes are made in the installation of the system. Improvement Permit with plat valid without expiration. Improvement Permit with site plan valid for sixty months. Authorization to Construct is valid for a period equal to that of Improvement Permit – not to exceed sixty months.

Signed: [signature] date 5/5/04 Installed by: James Hudler (8/24/04)

Improvement Permit by: William O. Johnson date 4/29/04 Operation Permit by: William O. Johnson date 11/4/04

Authorization to Construct by: William O. Johnson date 4/29/04 Existing System Inspection by: date

HEALTH DEPT. COPY: WHITE OWNER COPY (FINAL): YELLOW OWNER COPY (INITIAL): PINK