IREDELL COUNTY HEALTH DEPARTMENT

STATESVILLE 704-878-5305 MOORESVILLE 704-664-5281

IMPROVEMENT PERMIT / CERTIFICATE OF COMPLETION / OPERATION PERMIT / EXISTING SYSTEM INSPECTION

PROPERTY DESCRIPTION NO. REPAIR DATE 8/3/93 TAX MAP NO. REPAIR

OWNER OR CONTRACTOR ALICE MAY PHONE: Business 878-0542 Home

ADDRESS 333 N. KELLY ST. STATESVILLE NC 28677

LOCATION NC 115 N, TR S. CHIPLEY ROAD RD, 3RD (R) ON (L) BEFORE SOUTH RIVER BAPT. CH.

SUBDIVISION CHIPLEY PARK BLOCK / SECTION LOT 298-301 LOT AREA AMPLE SITE CLASS. PS L.T.A.R. EXISTING

Water Supply: ☑ Individual ☐ Community ☐ Public

Septic Tank: EXISTING Gallons: STB Date

Pump Tank: Gallons; PT Date

Nitrification Field: No Fields 1 Square Feet 540 Linear Feet 90 (6' BED)

No Lines 1 BED Trench Width 6' Trench Depth 30" Gravel Depth 18"

☐ New System ☑ Repair System Type: I, II, III, IV, V, VI

System Description: CONV. GRAVITY

Repair System Description:

Maintenance Agreement Required: ☐ Yes ☑ No

☐ House/Mod. Home No. Bedrooms

☐ Mobile Home No. Bathrooms

☐ Business No. Employees

☐ Other

☐ Slab ☐ Crawl Space ☐ Basement w/plumbing ☐ Basement wo/plumbing

Garbage Disposal: ☐ Yes ☐ No


Auto. Dishwasher: ☐ Yes ☐ No

Auto. Washing Machine: ☐ Yes ☐ No

Other

Comments INSTALL NEW 6' X 90' BED INTERSECTING EXISTING LINES AS SHOWN USING 18" STONE.

INITIAL SITE SKETCH

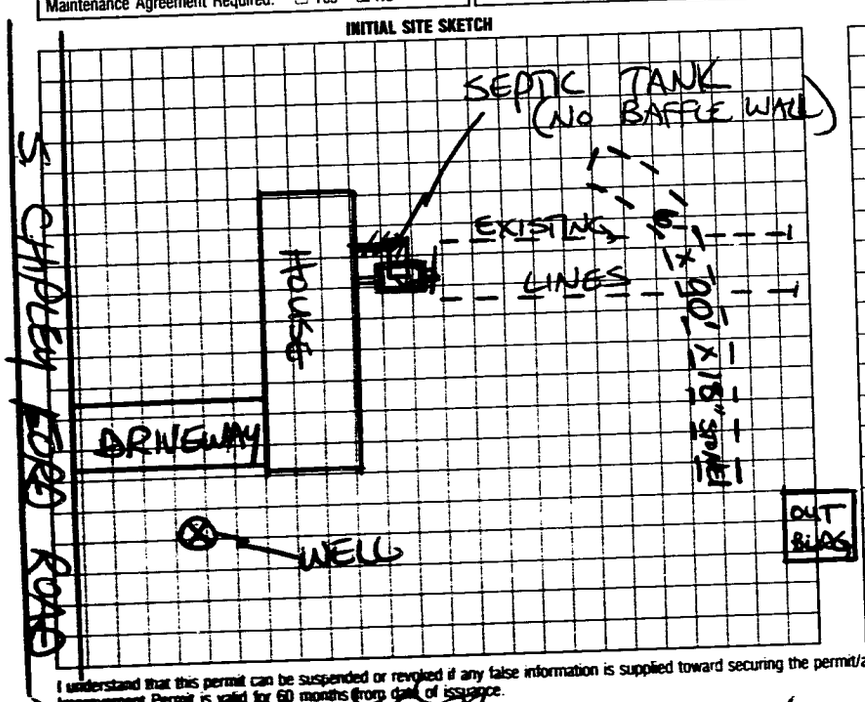

AS BUILT SKETCH

SYSTEM REPAIRED ACCORDING TO INITAL SITE SKETCH

I understand that this permit can be suspended or revoked if any false information is supplied toward securing the permit/any unauthorized changes are made to the site/any unauthorized changes are made in the installation of the system. Improvement Permit is valid for 60 months from date of issuance.

Signed: X Alice R. May

Improvement Permit by: STEVE HENRICK date 8/3/93

Existing System Inspection by: date

Installed by: JAMES HUDLER

Certificate of Completion by: STEVE HENRICK date 8/10/93

Operation Permit by: date

HEALTH DEPT. COPY: WHITE INSPECTION COPY (FINAL): GREEN OWNER COPY (FINAL): YELLOW INSPECTION COPY (INITIAL): PINK OWNER COPY (INITIAL): GOLD