#5

IREDELL COUNTY HEALTH DEPARTMENT

Statesville Office (704) 878-5305 Mooresville Office (704) 660-3625 PERMIT # 225894

IMPROVEMENT PERMIT / AUTHORIZATION TO CONSTRUCT / OPERATION PERMIT / EXISTING SYSTEM

PIN # 4736-59-7503

APPLICANT: BRIAN ROGERS APPLICANT ADDRESS: 867 SHEW RIDGE MISSION RD. WILKESBORO

SITE ADDRESS: 2629 S. CHIPLEY FORD RD. STATESVILLE PHONE: 704-450-9633 ALT. PHONE:

SITE DIRECTIONS: 21N, TR CHIPLEY FORD, ON L past SUMMERS FARM RD.

SUBDIVISION: Chipley Park SECTION: 3 LOT # 294-297 LOT AREA: DESIGN FLOW: 360 L.T.A.R.:

Septic Tank 1000 (gal) STB Date

Pump Tank (gal) PT Date

Pump Make Model Serial #

Nitrification Fields EXISTING # Lines Linear Ft:

Trench Width Max. Trench Bottom Depth Gravel Depth

☐ New System ☑ Repair ☐ Expansion System Type: I (II) III IV V VI

System Description:

Repair System Description: TANK

Maintenance Agreement Required: ☐ YES ☑ NO

☑ GRAVITY ☐ PRESSURE

☑ Residence ☐ Business ☐ Other ☐ Slab ☐ Basement w/plumbing


No. Bedrooms 3 No. Persons 6 No. Employees

☑ Crawl Space ☐ Basement w/o plumbing


Water Supply: ☑ Private ☐ Public ☐ Community

Comments / Conditions: PUMP, CRUSH & FILL OLD TANK

INITIAL SITE SKETCH

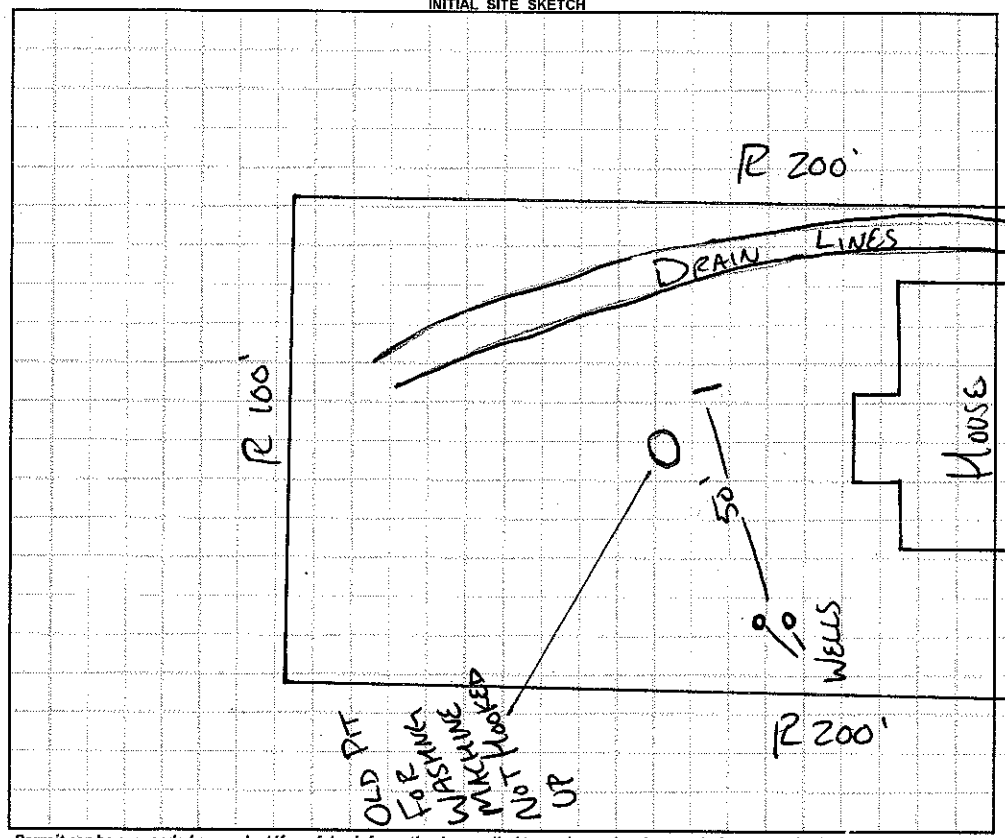

AS BUILT SKETCH

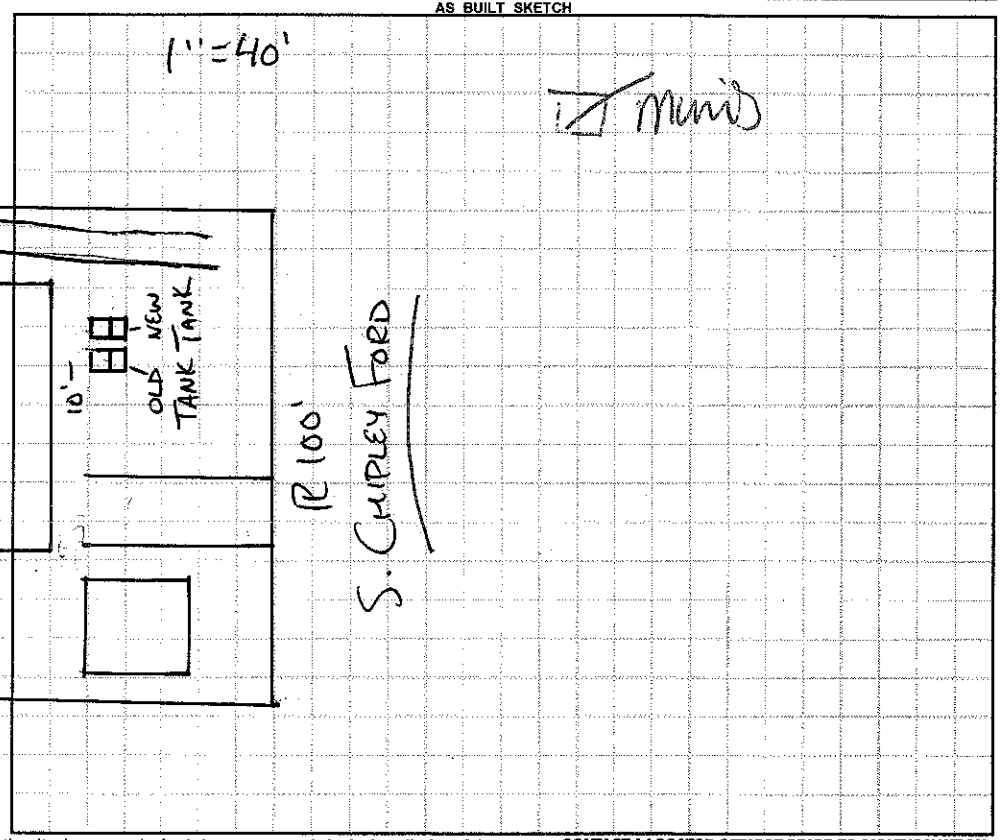

Permit can be suspended or revoked if any false information is supplied toward securing the permit, any unauthorized changes are made to the site / any unauthorized changes are made in the installation of the system. **CONTACT A LOCATOR SERVICE PRIOR TO ANY EXCAVATION**

☐ **IMPROVEMENT PERMIT** *with plat valid without expiration.* ☑ **IMPROVEMENT PERMIT** *with site plan valid for 60 mos.* ☑ **AUTHORIZATION TO CONSTRUCT** *valid for period equal to IMPROVEMENT PERMIT--not to exceed 60 mo.*

Owner / Applicant Signature: Date: 4/12/17 Installed by: K+M Grading - Kevin Bowls.

IMPROVEMENT PERMIT by: Date: 4-12-17 OPERATION PERMIT by: B. Botkins. Date: 4/12/17

AUTHORIZATION TO CONSTRUCT by: Date: 4-12-17 Existing System inspected by: Date:

Health Dept. Copy - WHITE Applicant (Final Approval) - YELLOW Applicant (Conditional Approval) - PINK