IREDELL COUNTY HEALTH DEPARTMENT

STATESVILLE 704-878-5305 MOORESVILLE 704-664-5281

IMPROVEMENT PERMIT / AUTHORIZATION TO CONSTRUCT / OPERATION PERMIT / EXISTING SYSTEM INSPECTION

PERMIT# 130094 PIN# 4736461397 DATE 7-28-05

OWNER OR CONTRACTOR Manny Lippard Construction PHONE: Business 704-902-4918 Home

ADDRESS 129 Verna Drive Statesville NC 28625

LOCATION 21 N (L) Fort Dobbs RD (R) Cedar Lake LN

SUBDIVISION Dobbs Valley BLOCK / SECTION II LOT 30 LOT AREA 1.382 AC SITE CLASS. RS DESIGN FLOW 480 L.T.A.R. .3

Septic Tank: 1000 Gallons; STB 1012 Date

Pump Tank: Gallons; PT Date

Pump Make: Model Serial No.

Nitrification Field: No Fields Square Feet 1600 Linear Feet 400

No Lines 4 Trench Width 36" Max Trench Bottom Depth 36" Gravel Depth NA

☐ New System ☐ Repair System Type: I (II) III, IV, V, VI

System Description: 25% Grade

Repair System Description: 25% Grade

Maintenance Agreement Required: ☐ Yes ☐ No

☐ House/Mod. Home No. Bedrooms 4

☐ Mobile Home No. Bathrooms

☐ Business No. Employees

☐ Other


Water Supply: ☐ Individual ☐ Public ☐ Community

☐ Slab ☐ Crawl Space ☐ Basement w/plumbing ☐ Basement wo/plumbing

Comments/Conditions: Install lines on Contours less than 25% grade (1" = 60' scale) Use Effluent Splitter

Comments/Conditions: Yellow tag - tile field Septic tank inside

INITIAL SITE SKETCH

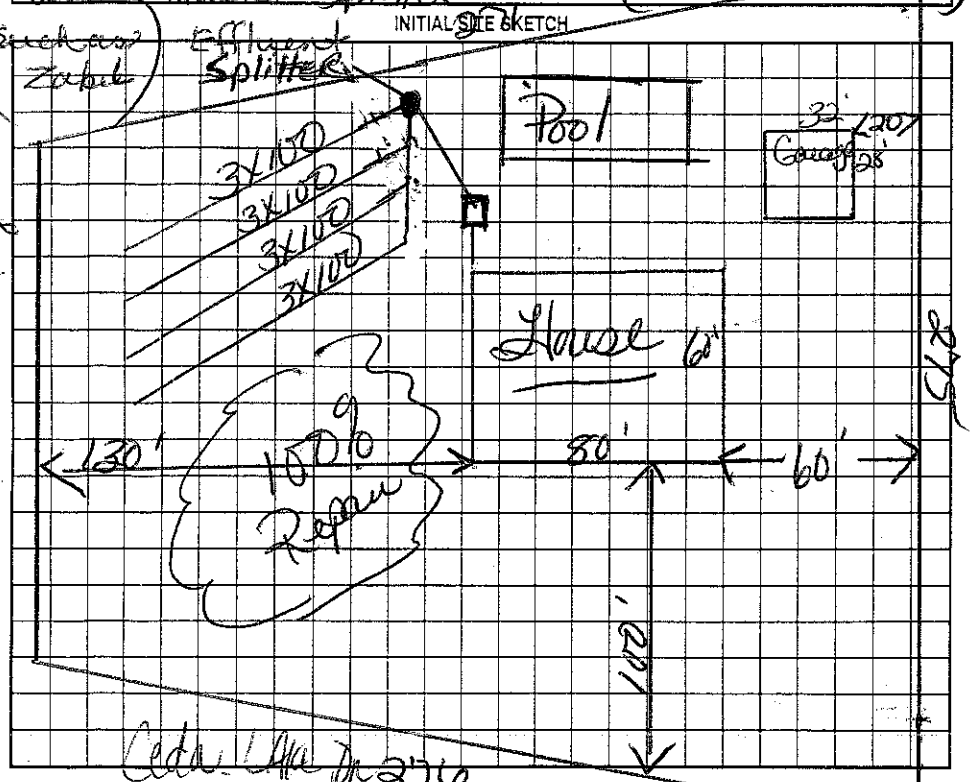

AS BUILT SKETCH

Permit can be suspended or revoked if any false information is supplied toward securing the permit/any unauthorized changes are made to the site/any unauthorized changes are made in the installation of the system. Improvement Permit with plat valid without expiration. Improvement Permit with site plan valid for sixty months. Authorization to Construct is valid for a period equal to that of Improvement Permit – not to exceed sixty months.

Signed: Budgett L. Lippard date 8-2-05 Installed by: DAVID Grantham

Improvement Permit by: Kelly Cook date 7-28-05 Operation Permit by: Kelly Cook date 3-13-06

Authorization to Construct by: Kelly Cook date 7-28-05 Existing System Inspection by: date

HEALTH DEPT. COPY: WHITE OWNER COPY (FINAL): YELLOW OWNER COPY (INITIAL): PINK