STATESVILLE

IMPROVEMENT PERMIT / AUTHORIZATION TO CONSTRUCT / OPERATION PERMIT / EXISTING SYSTEM

PERMIT # 2210[illegible]

APPLICANT: John Piland

PIN # 4736604892 5838

SITE ADDRESS: 135 Cedar Lake Statesville, NC 28625

APPLICANT ADDRESS: 135 Cedar Lake Dr Statesville, NC 28625

SITE DIRECTIONS: Hwy 115N TR Cripley Ford Rd TR Ft. Dobbs TL Cedar Lake Cove on left

PHONE:

ALT. PHONE:

SUBDIVISION: DOBBS Valley

SECTION: 2 LOT # 49 LOT AREA:

DESIGN FLOW: 600 gpd L.T.A.R.: .13


Septic Tank	1500 (gal)	STB	Date	☐ New System	☐ Repair	☒ Expansion	System Type: I II (III) IV V VI	☒ Residence	No. Bedrooms 5
Pump Tank	(gal)	PT	Date	System Description:			Gravity – 25% Reduction	☐ Business	No. Persons 10
Pump Make		Model	Serial #	Repair System Description:			Gravity/Pump – 25% Reduction	☐ Other	No. Employees
# Nitrification Fields	1	# Lines	3 @ 75' Linear Ft: 225	Maintenance Agreement Required:		☐ YES	☒ NO	☐ Slab	☐ Crawl Space
Trench Width	36"	Max. Trench Bottom Depth	36"	Gravel Depth	N/A	☒ GRAVITY	☐ PRESSURE	☒ Basement w/ plumbing	☐ Basement w/o plumbing

Water Supply: ☐ Private ☒ Public ☐ Community


Comments / Conditions: Note: OK to add second ST if gravity from ST to drainfield can be maintained.

Expansion from 3 Bedrooms to 5 Bedroom

INITIAL SITE SKETCH

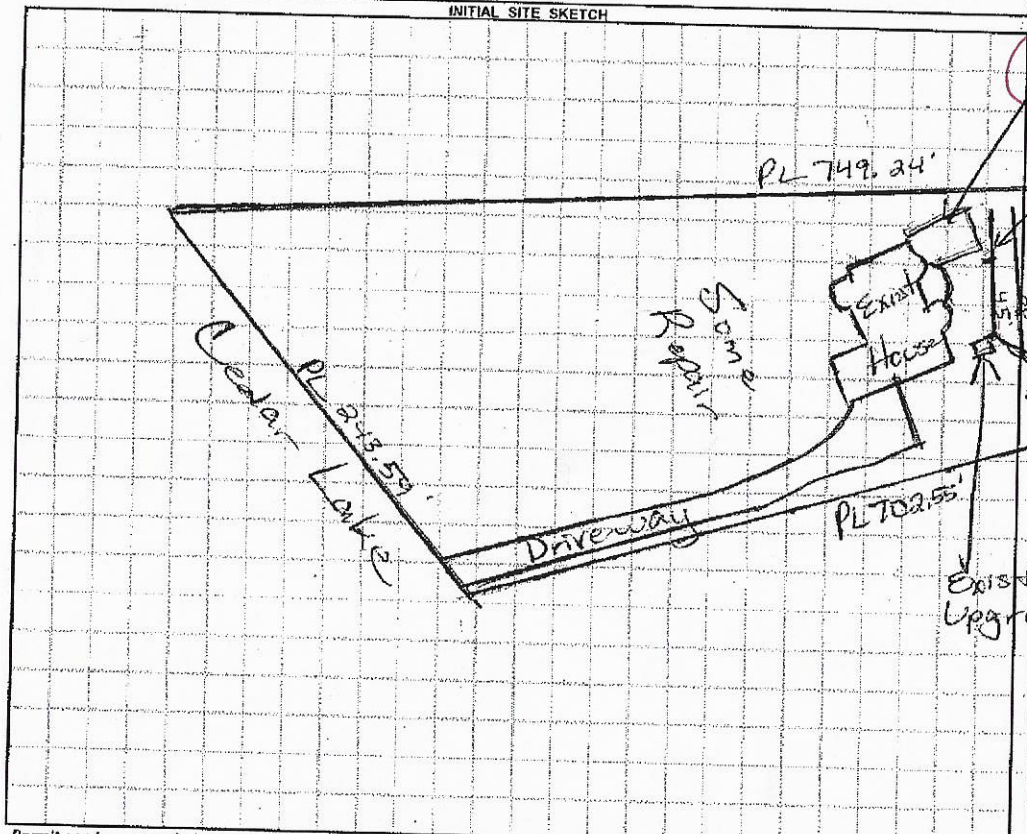

AS BUILT SKETCH

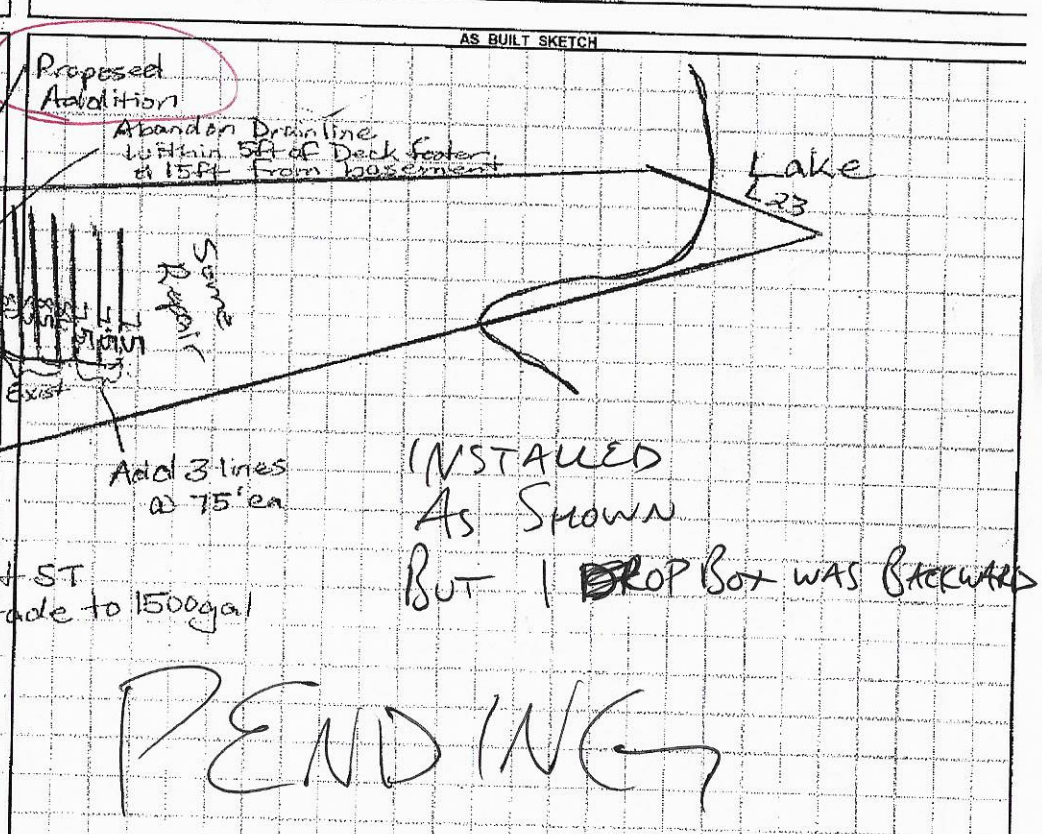

Permit can be suspended or revoked if any false information is supplied toward securing the permit / any unauthorized changes are made to the site / any unauthorized changes are made in the installation of the system. **CONTACT A LOCATOR SERVICE PRIOR TO ANY EXCAVATION**

☐ **IMPROVEMENT PERMIT** *with plat valid without expiration.* ☐ **IMPROVEMENT PERMIT** *with site plan valid for 60 mos.* ☐ **AUTHORIZATION TO CONSTRUCT** *valid for period equal to IMPROVEMENT PERMIT--not to exceed 60 mo.*

Owner / Applicant Signature:

IMPROVEMENT PERMIT by: Maina Dotson RS Date: 10/11/16

AUTHORIZATION TO CONSTRUCT by: Maina Dotson RS Date: 10/8/16

Installed by: ABERNATHY

OPERATION PERMIT by: Ben Aldridge BA Date: 2/22/17

Existing System Inspected by: Date: 10/8/16

Health Dept. Copy - WHITE Applicant (Final Approval) - YELLOW Applicant (Conditional Approval) - PINK

Bldg. C/O issued 2/23/17